AMP Old # 176908

IREDELL COUNTY HEALTH DEPARTMENT

Statesville Office (704) 878-5305 Mooresville Office (704) 660-3625 PERMIT # 205430

IMPROVEMENT PERMIT / AUTHORIZATION TO CONSTRUCT / OPERATION PERMIT / EXISTING SYSTEM

✓ PIN # 4740 52 9497

APPLICANT: ELG INVESTMENTS LLC APPLICANT ADDRESS: 16108 NORTH POINT RD HUNTERSVILLE NC 28078

SITE ADDRESS: 144 HAWKS LANDING TROUTMAN 28166 PHONE: 704-578-4951 ALT. PHONE:

SITE DIRECTIONS: 21N (L) FLOWER HOUSE (R) HAWKS LANDING (L) ON (R)

SUBDIVISION: HAWKS LANDING SECTION: — LOT # 9 LOT AREA: 1.019AC DESIGN FLOW: 360 L.T.A.R.: .25 gpd/ft²

Septic Tank	1000	(gal)	STB 760	Date	6/25	☒ New System	☐ Repair	☐ Expansion	System Type: I II (III) IV V VI	☒ Residence	No. Bedrooms	3	Water Supply		
Pump Tank	~~1000~~	(gal)	PT	Date		System Description:	25% REDUCTION			☐ Business	No. Persons	6	☒ Private		
Pump Make		Model		Serial #		Repair System Description:	PPBPS - LPP DISTRIBUTION			☐ Other	No. Employees		☐ Public		
# Nitrification Fields	1	# Lines	5	Linear Ft:	360	Maintenance Agreement Required:	☐ YES	☒ NO		☒ Slab	☐ Crawl Space		☐ Community		
Trench Width	3	Max. Trench Bottom Depth	36"	Gravel Depth	NA		☒ GRAVITY	☐ PRESSURE		☐ Basement w/plumbing			☐ Basement w/o plumbing		

Comments / Conditions: KEEP LINES ON CONTOUR AS PER DESIGN

CONTOUR SLIGHTLY CHANGED. ESSENTIALLY INSTALLED AS DESIGNED. EXTRA LINE ADDED IN AND SOME OFF OF 100' INITIAL LINE SHORTENED.

INITIAL SITE SKETCH

SEE PLAN FROM THE OAKS GROUP approved JCHD 8-28-14

AS BUILT SKETCH

Permit can be suspended or revoked if any false information is supplied toward securing the permit / any unauthorized changes are made to the site / any unauthorized changes are made in the installation of the system. **CONTACT A LOCATOR SERVICE PRIOR TO ANY EXCAVATION**

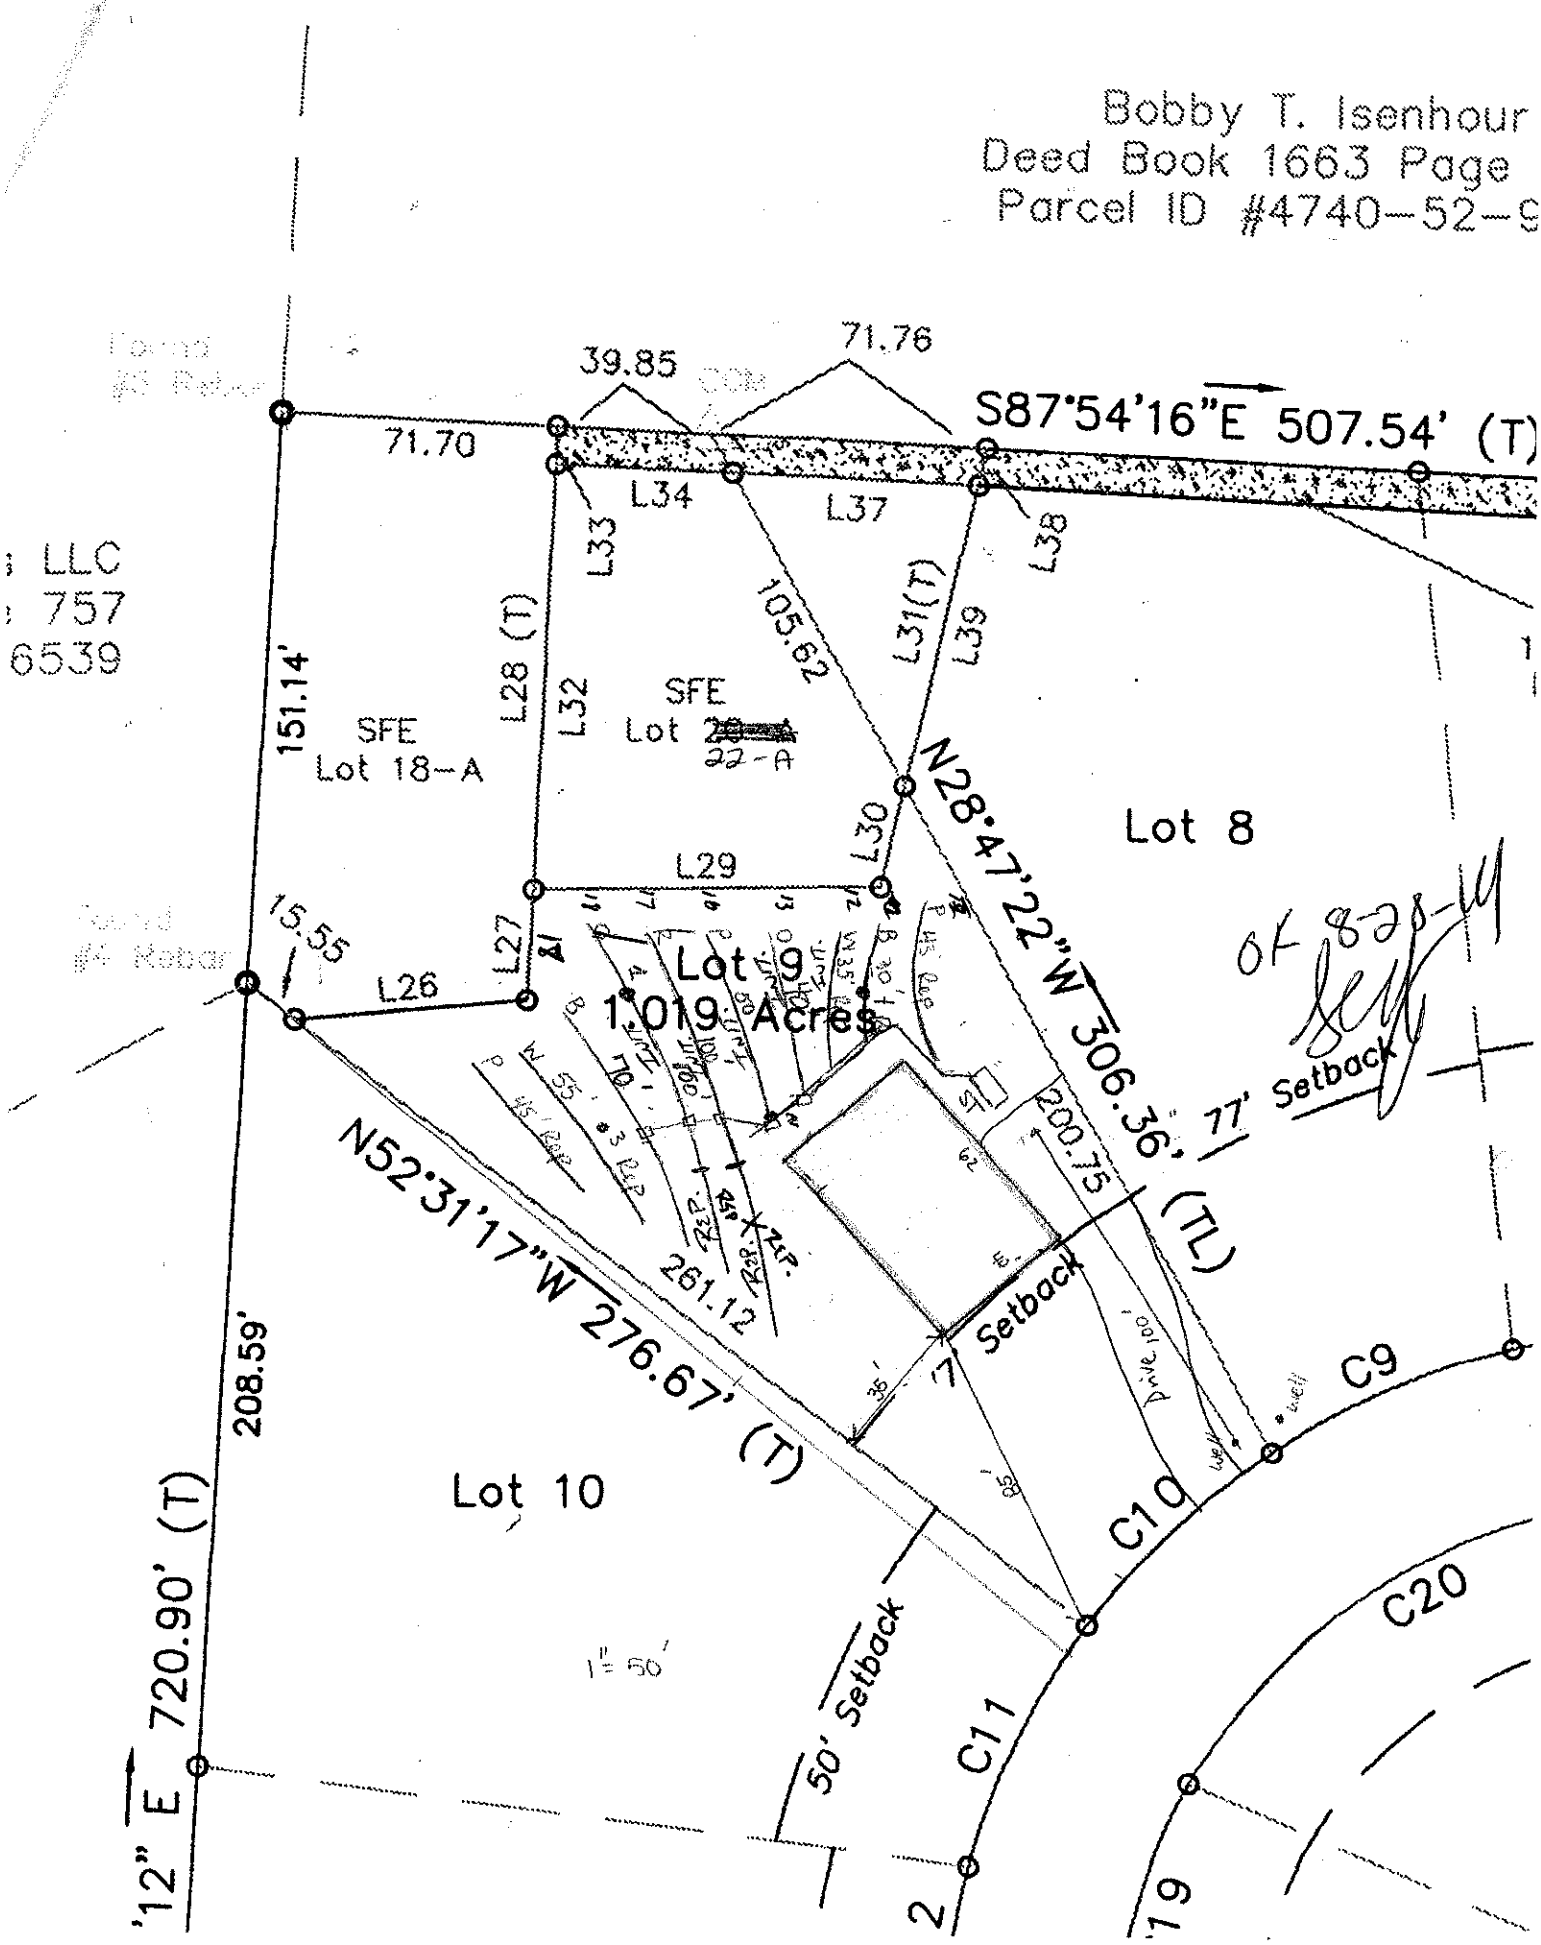
☐ **IMPROVEMENT PERMIT** *with plat valid without expiration.* ☒ **IMPROVEMENT PERMIT** *with site plan valid for 60 mos.* ☒ **AUTHORIZATION TO CONSTRUCT** *valid for period equal to IMPROVEMENT PERMIT--not to exceed 60 mo.*

Owner / Applicant Signature: Date: 8-29-14 Installed by: A1 Backhoe

IMPROVEMENT PERMIT by: Steve Gray REHS-LSS Date: 8-28-14 OPERATION PERMIT by: APPROVED Date: NOV 14 2014

AUTHORIZATION TO CONSTRUCT by: Steve Gray REHS-LSS Date: 8-28-14 Existing System Inspected by: Date:

Health Dept. Copy - WHITE Applicant (Final Approval) - YELLOW Applicant (Conditional Approval) - PINK


Bobby T. Isenhour
Deed Book 1663 Page
Parcel ID #4740-52-9
S87°54'16"E 507.54' (T)
71.70
39.85
71.76
L33
L34
L37
L38
L39
L31(T)
105.62
L28 (T)
L32
151.14'
SFE
Lot 18-A
SFE
Lot 22-A
L30
N28°47'22"W 306.36' (TL)
Lot 8
L29
L27
L26
15.55
Lot 9
1.019 Acres
N52°31'17"W 276.67' (T)
261.12
200.75
77' Setback
7' Setback
35'
50' Setback
208.59'
'12" E 720.90' (T)
Lot 10
C9
C10
C11
C20
1" = 50'
Of 8-29-11