IREDELL COUNTY HEALTH DEPARTMENT

Authorization to Construct

STATESVILLE 704-878-5305 MOORESVILLE 704-664-5281

100

IMPROVEMENT PERMIT / ~~CERTIFICATE OF COMPLETION~~ / OPERATION PERMIT / EXISTING SYSTEM INSPECTION

PROPERTY DESCRIPTION NO. 066986 DATE 7/2/97 TAX MAP NO. 4740540927 Watershed: ☐ Yes ☒ No

OWNER OR CONTRACTOR Jimmy Johnson PHONE: Business _____ Home N/A

ADDRESS PO Box 447 Troutman, NC. 28166

LOCATION Life Rd. ; (L) off Flower House Loop ~ .5 mile on (R)

SUBDIVISION No BLOCK / SECTION _____ LOT _____ LOT AREA ~1.5Ac SITE CLASS. PS DESIGN FLOW 360 L.T.A.R. .3

Septic Tank: 1000 Gallons; STB 1012 Date 5/7/97

Pump Tank: _____ Gallons; PT _____ Date _____

Pump Make: _____ Model _____ Serial No. _____

Nitrification Field: No Fields 1 Square Feet 1200 Linear Feet ~400

No Lines 5 Trench Width 36" Max Trench Bottom Depth 30" Gravel Depth STONE

☒ New System ☐ Repair System Type: I, II, (III) IV, V, VI

System Description: GRAVITY - CIT PLASTIC

Repair System Description: _____

Maintenance Agreement Required: ☐ Yes ☒ No

☐ House/Mod. Home ☒ Mobile Home ☐ Business ☐ Other _____

No. Bedrooms 3 No. Bathrooms 2 No. Employees _____


☐ Slab ☒ Crawl Space ☐ Basement w/plumbing ☐ Basement wo/plumbing

Water Supply: ☒ Individual ☐ Community ☐ Public

Comments: 205'

50'

INITIAL SITE SKETCH

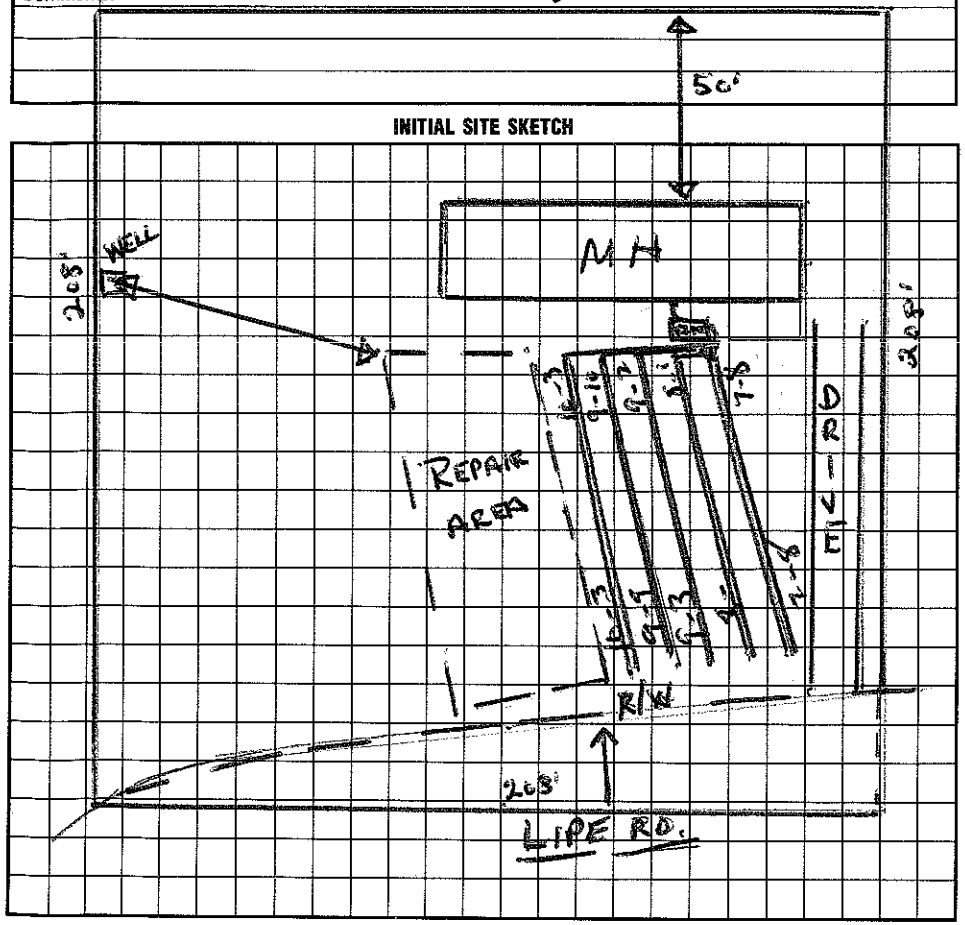

Comments:

AS BUILT SKETCH

I understand that this permit can be suspended or revoked if any false information is supplied toward securing the permit/any unauthorized changes are made to the site/any unauthorized changes are made in the installation of the system. Improvement Permit is valid for 60 months from date of issuance.

Signed: _____

Improvement Permit by: Wesley Sparks RS date 7/2/97

Existing System Inspection by: Wesley Sparks RS. date 7/2/97

Installed by: Dennis Sublett

Certificate of Completion by: Wesley Sparks RS date 7/3/97

Operation Permit by: Wesley Sparks RS. date 7/3/97

HEALTH DEPT. COPY: WHITE INSPECTION COPY (FINAL): GREEN OWNER COPY (FINAL): YELLOW INSPECTION COPY (INITIAL): PINK OWNER COPY (INITIAL): GOLD