IREDELL COUNTY HEALTH DEPARTMENT

AUTHORIZATION TO CONSTRUCT

4740544483

STATESVILLE 704-878-5305 MOORESVILLE 704-664-5281

IMPROVEMENT PERMIT / ~~CERTIFICATE OF COMPLETION~~ / OPERATION PERMIT / EXISTING SYSTEM INSPECTION

PROPERTY DESCRIPTION NO. 068936 DATE 8/29/97 TAX MAP NO. 4740544483 Watershed: ☐ Yes ☑ No

OWNER OR CONTRACTOR JOHN STALLINGS PHONE: Business _____ Home 528-5055

ADDRESS PO BOX 222 TROUTMAN NC 28166

LOCATION 21 N - TL FLOWER HOUSE LOOP - TR LIPE RD - ON LT

SUBDIVISION — BLOCK / SECTION — LOT 3 LOT AREA 3.87 SITE CLASS. PS DESIGN FLOW 270 L.T.A.R. .3

Septic Tank: 1000 Gallons; STB 794 Date 7/29/97

Pump Tank: _____ Gallons; PT _____ Date _____

Pump Make: _____ Model _____ Serial No. _____

Nitrification Field: No Fields 1 Square Feet 794 Linear Feet 268

No Lines 4@67' Trench Width 36" Max Trench Bottom Depth 36" Gravel Depth 12"

☑ New System ☐ Repair System Type: I, (II), III, IV, V, VI

System Description: GRAVITY CONVENTIONAL

Repair System Description: SAME

Maintenance Agreement Required: ☐ Yes ☑ No

☐ House/Mod. Home ☑ Mobile Home ☐ Business ☐ Other

No. Bedrooms 3 No. Bathrooms 1 No. Employees ____


☐ Slab ☑ Crawl Space ☐ Basement w/plumbing ☐ Basement wo/plumbing

Water Supply: ☑ Individual ☐ Community ☐ Public


Comments:

Comments:

INITIAL SITE SKETCH 1" = 100'

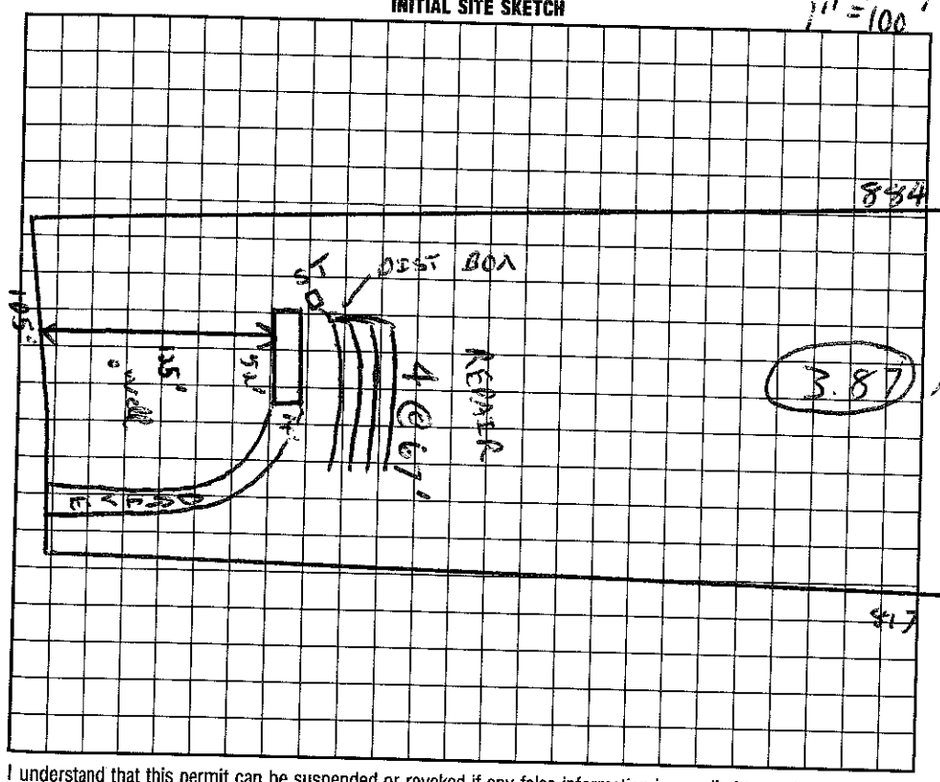

AS BUILT SKETCH

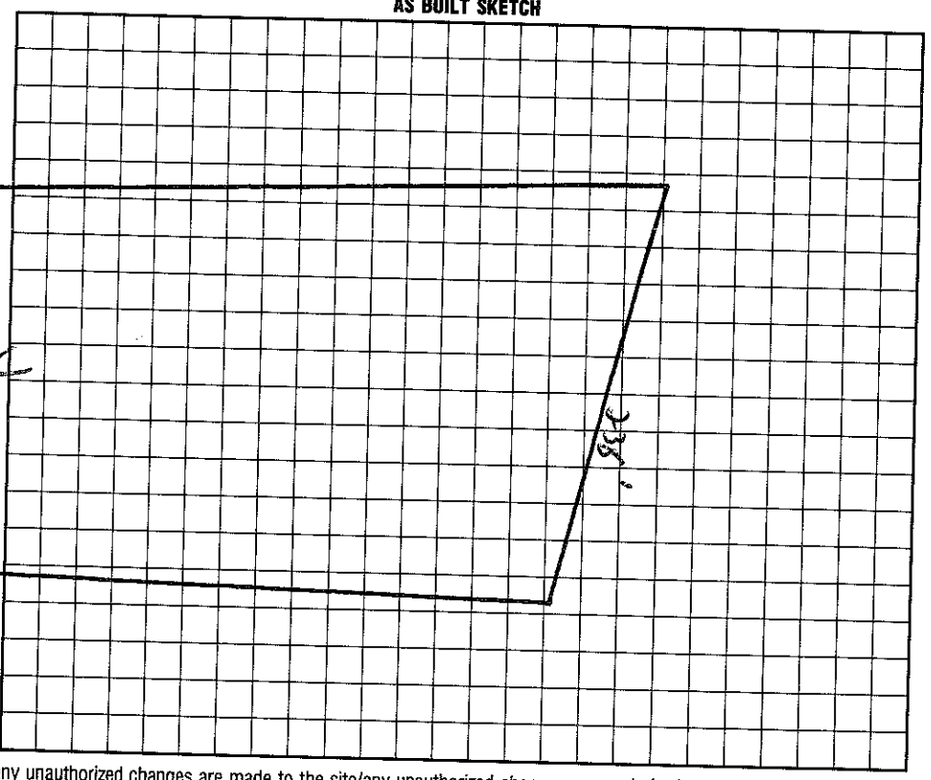

I understand that this permit can be suspended or revoked if any false information is supplied toward securing the permit/any unauthorized changes are made to the site/any unauthorized changes are made in the installation of the system. Improvement Permit is valid for 60 months from date of issuance.

Signed: John D Stallings

Improvement Permit by: C. Brady Freeman date 8/29/97

AUTHORIZATION TO ~~Existing System Inspection by:~~ C. Brady Freeman date 8/29/97 CONSTRUCT

Installed by: JAMES HUDIER

Certificate of Completion by: _____ date _____

Operation Permit by: C. Brady Freeman RS date 10/23/97

HEALTH DEPT. COPY: WHITE INSPECTION COPY (FINAL): GREEN OWNER COPY (FINAL): YELLOW INSPECTION COPY (INITIAL): PINK OWNER COPY (INITIAL): GOLD