IREDELL COUNTY HEALTH DEPARTMENT

Navigation to Construct [redacted] 474054496

STATESVILLE 704-878-5305 MOORESVILLE 704-664-5281

IMPROVEMENT PERMIT / ~~CERTIFICATE OF COMPLETION~~ / OPERATION PERMIT / EXISTING SYSTEM INSPECTION

PROPERTY DESCRIPTION NO. 26131 DATE 3/11/97 TAX MAP NO. 4740457280 Watershed: ☐ Yes ☒ No

OWNER OR CONTRACTOR Clarence Lambert PHONE: Business _____ Home 528-0928

ADDRESS 196 Lipe Rd Statesville NC 28166

LOCATION 115-21N TL Flowerhouse Loop TL Lipe Road a 3/4 mile TR on dirt

SUBDIVISION _____ BLOCK / SECTION _____ LOT 1 LOT AREA _____ SITE CLASS. PS DESIGN FLOW 360 L.T.A.R. .3

Septic Tank: 1000 Gallons; STB 794 Date 7/7/97

Pump Tank: _____ Gallons; PT _____ Date _____

Pump Make: _____ Model _____ Serial No. _____

Nitrification Field: No Fields 1 Square Feet 1200 Linear Feet 400

No Lines 3 Trench Width 36" Max Trench Bottom Depth 36" Gravel Depth 12"

☒ New System ☐ Repair System Type: I, II, III, IV, V, VI

System Description: CONVENTIONAL.

Repair System Description: _____

Maintenance Agreement Required: ☐ Yes ☐ No

☐ House/Mod. Home ☒ Mobile Home ☐ Business ☐ Other _____

No. Bedrooms 3 No. Bathrooms 1 No. Employees _____


☐ Slab ☒ Crawl Space ☐ Basement w/plumbing ☐ Basement w/o plumbing

Water Supply: ☒ Individual ☐ Community ☐ Public


Comments:

Comments: 7/8/97 - STB 794

INITIAL SITE SKETCH

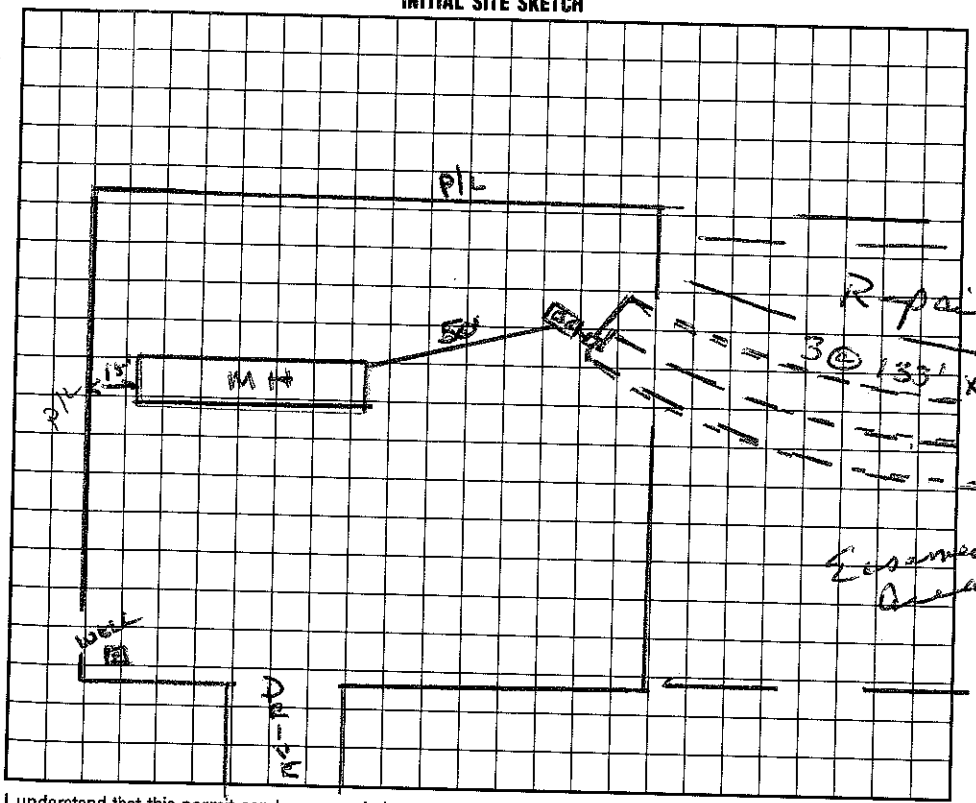

AS BUILT SKETCH

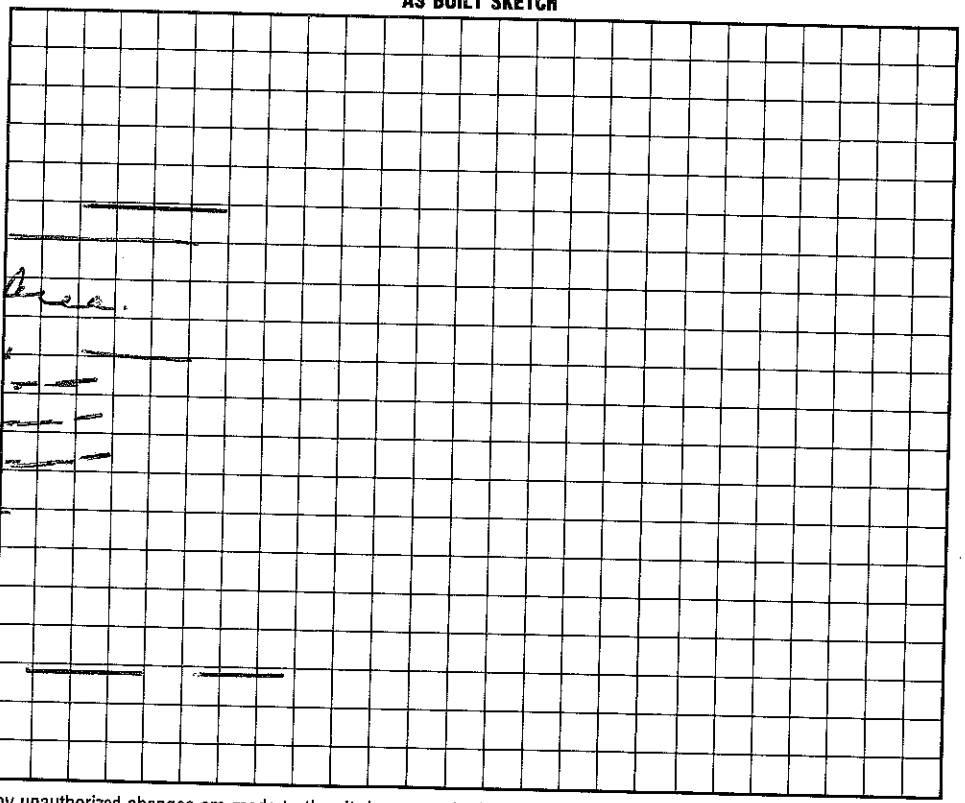

I understand that this permit can be suspended or revoked if any false information is supplied toward securing the permit/any unauthorized changes are made to the site/any unauthorized changes are made in the installation of the system. Improvement Permit is valid for 60 months from date of issuance.

Signed: * Glenda M. Lambert 3-12-97

Improvement Permit by: Wesley Sparks RS. date 3/11/97

~~Existing System Inspection by~~: Wesley Sparks RS. date 3/11/97

Installed by: James Huddleston

Certificate of Completion by: Wesley Sparks RS date 3/5/98

Operation Permit by: Wesley Sparks RS. date 3/5/98

HEALTH DEPT. COPY: WHITE INSPECTION COPY (FINAL): GREEN OWNER COPY (FINAL): YELLOW INSPECTION COPY (INITIAL): PINK OWNER COPY (INITIAL): GOLD