IREDELL COUNTY HEALTH DEPARTMENT

Auth to Construct

STATESVILLE 704-878-5305 — MOORESVILLE 704-664-5281

4740344496

IMPROVEMENT PERMIT / ~~CERTIFICATE OF COMPLETION~~ / OPERATION PERMIT / EXISTING SYSTEM INSPECTION

PROPERTY DESCRIPTION NO. 26290 DATE 3/11/97 TAX MAP NO. 4740562327

OWNER OR CONTRACTOR Clarence Lambert PHONE: Business _____ Home 528-0928

ADDRESS 190 Lipe Rd. Troutman, NC. 28166 Watershed: ☐ Yes ☒ No

LOCATION 115-2 N TL Flowers Home Loop TL Lipe Rd. n 3/4 mile TR on drive

SUBDIVISION _____ BLOCK / SECTION _____ LOT _____ LOT AREA ~1ac SITE CLASS. PS DESIGN FLOW 360 L.T.A.R. .3

Septic Tank: 1000 Gallons; STB 794 Date 3/11/97

Pump Tank: _____ Gallons; PT _____ Date _____

Pump Make: _____ Model _____ Serial No. _____

Nitrification Field: No Fields 1 Square Feet 1200 Linear Feet 400

No Lines @ 4 Trench Width 36" Max Trench Bottom Depth 36" Gravel Depth 12"

☒ New System ☐ Repair System Type: I, II, III, IV, V, VI

System Description: Conventional

Repair System Description: _____

Maintenance Agreement Required: ☐ Yes ☐ No

☒ House/Mod. Home ☐ Mobile Home ☐ Business ☐ Other

No. Bedrooms 3 No. Bathrooms 2 No. Employees _____

☐ Slab ☒ Crawl Space ☐ Basement w/plumbing ☐ Basement wo/plumbing


Water Supply: ☒ Individual ☐ Community ☐ Public

Comments:

Comments:

Installed as drawn on Auth Construct

INITIAL SITE SKETCH

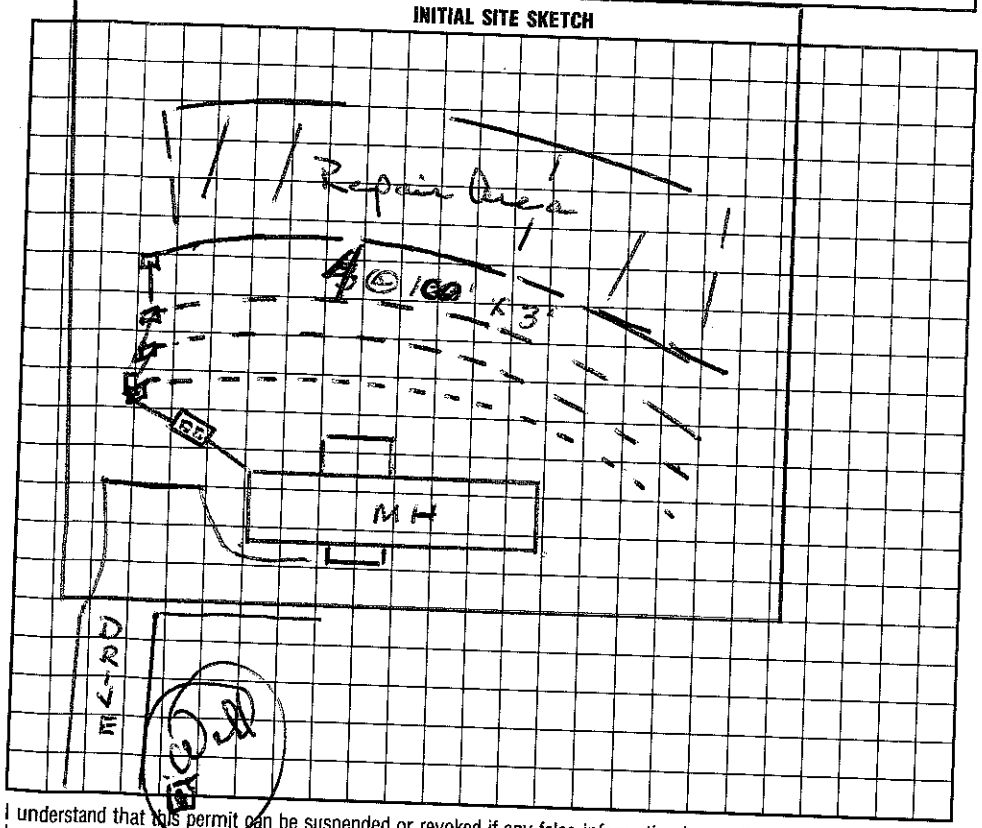

AS BUILT SKETCH

I understand that this permit can be suspended or revoked if any false information is supplied toward securing the permit/any unauthorized changes are made to the site/any unauthorized changes are made in the installation of the system. Improvement Permit is valid for 60 months from date of issuance.

Signed: ✕ Clarence M Lambert 3-12-97

Improvement Permit by: Wesley Sparks R.S. date 3/11/97

Existing System Inspection by: Wesley Sparks R.S. date 3/11/97

Installed by: Jimmie Hundley

Certificate of Completion by: Wesley Sparks R.S. date 3/5/98

Operation Permit by: Wesley Sparks R.S. date 3/5/98

HEALTH DEPT. COPY: WHITE — INSPECTION COPY (FINAL): GREEN — OWNER COPY (FINAL): YELLOW — INSPECTION COPY (INITIAL): PINK — OWNER COPY (INITIAL): GOLD