4740546432

IREDELL COUNTY HEALTH DEPARTMENT

STATESVILLE 704-878-5305 MOORESVILLE 704-664-5281

IMPROVEMENT PERMIT / CERTIFICATE OF COMPLETION / OPERATION PERMIT / EXISTING SYSTEM INSPECTION

PROPERTY DESCRIPTION NO. 17058 DATE 9/17/93 TAX MAP NO. 4F A93

OWNER OR CONTRACTOR Terry Helton PHONE: Business Home 528-3189

ADDRESS Rt 1 Box 301 Troutman, NC. 28166

LOCATION Lipe Rd, 11.5N TL on Upper FHLP. to 2nd (R) (Upper Rd.) ~.4 mile on (L)

SUBDIVISION N/A BLOCK / SECTION LOT LOT AREA ~2AC SITE CLASS. L.T.A.R.

Water Supply: [X] Individual [ ] Community [ ] Public

Septic Tank: 1000 Gallons; STB Date '86

Pump Tank: Gallons; PT Date

Nitrification Field: No Fields 1 Square Feet 900 Linear Feet 300

No Lines 4 Trench Width 3' Trench Depth 3' Gravel Depth 12"

[ ] New System [ ] Repair System Type: I, II, III, IV, V, VI

System Description: CONV - EXISTING

Repair System Description:

Maintenance Agreement Required: [ ] Yes [ ] No

[ ] House/Mod. Home [X] Mobile Home D-W [ ] Business [ ] Other

No. Bedrooms 3 No. Bathrooms 2 No. Employees

Garbage Disposal: [ ] Yes [X] No

Auto. Dishwasher: [X] Yes [ ] No

Auto. Washing Machine: [X] Yes [ ] No


Other

[ ] Slab [X] Crawl Space [ ] Basement w/plumbing [ ] Basement wo/plumbing

Comments

INITIAL SITE SKETCH

AS BUILT SKETCH

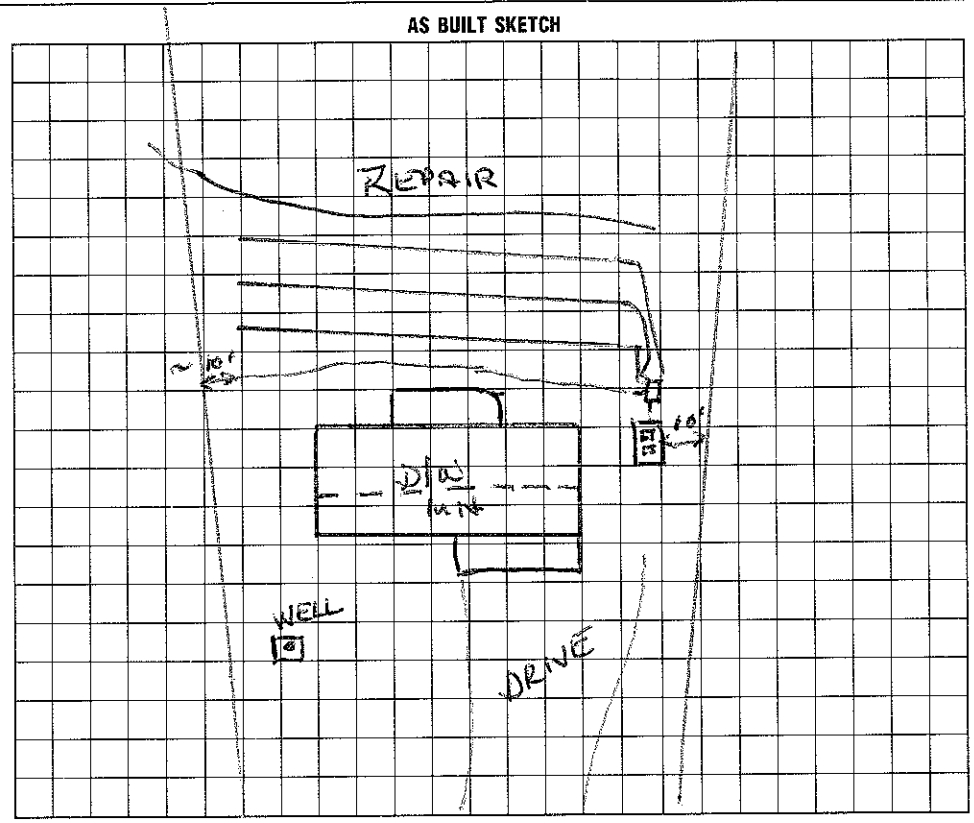

I understand that this permit can be suspended or revoked if any false information is supplied toward securing the permit/any unauthorized changes are made to the site/any unauthorized changes are made in the installation of the system. Improvement Permit is valid for 60 months from date of issuance.

Signed:

Improvement Permit by: date

Existing System Inspection by: Wesley Sparks date 9/17/93

Installed by: Barry Lingerman 12-19-86

Certificate of Completion by: date

Operation Permit by: date

HEALTH DEPT. COPY: WHITE INSPECTION COPY (FINAL): GREEN OWNER COPY (FINAL): YELLOW INSPECTION COPY (INITIAL): PINK OWNER COPY (INITIAL): GOLD