# IREDELL COUNTY HEALTH DEPARTMENT

STATESVILLE 704-878-5305 MOORESVILLE 704-664-5281

## IMPROVEMENT PERMIT / AUTHORIZATION TO CONSTRUCT / OPERATION PERMIT / EXISTING SYSTEM INSPECTION

PERMIT# 94009 PIN# ~~4740 55 2148~~ 4740 55 1179 DATE 2/13/01

OWNER OR CONTRACTOR Clarence Lambert PHONE: Business Home 528-0928

ADDRESS 190 Lipe Rd Trout man 28166

LOCATION 115 N, L Flower house, L Lipe, R Bryan on Rt

SUBDIVISION C. Lambert Prop. BLOCK / SECTION LOT 3 LOT AREA .78 SITE CLASS. PS DESIGN FLOW 360 L.T.A.R. 0.3

Septic Tank: 1000 Gallons; STB 620/928 Date 2/2/00

Pump Tank: Gallons; PT Date

Pump Make: Model Serial No.

Nitrification Field: No Fields 1 Square Feet 1200 Linear Feet 460

No Lines 4@100' Trench Width 36" Max Trench Bottom Depth 36" Gravel Depth 12"

☒ New System ☐ Repair System Type: I (II) III, IV, V, VI

System Description: Gravity Conventional

Repair System Description: Gravity 25% Reduc.

Maintenance Agreement Required: ☐ Yes ☒ No

☐ House/Mod. Home ☒ Mobile Home ☐ Business ☐ Other

No. Bedrooms 3 No. Bathrooms 2 No. Employees

☐ Slab ☒ Crawl Space ☐ Basement w/plumbing ☐ Basement wo/plumbing

Water Supply: ☒ Individual ☐ Public ☐ Community


Shared Well

Comments:/Conditions: Install Lines on Contour

Comments:/Conditions:

Installed as drawn.

Not to Scale INITIAL SITE SKETCH

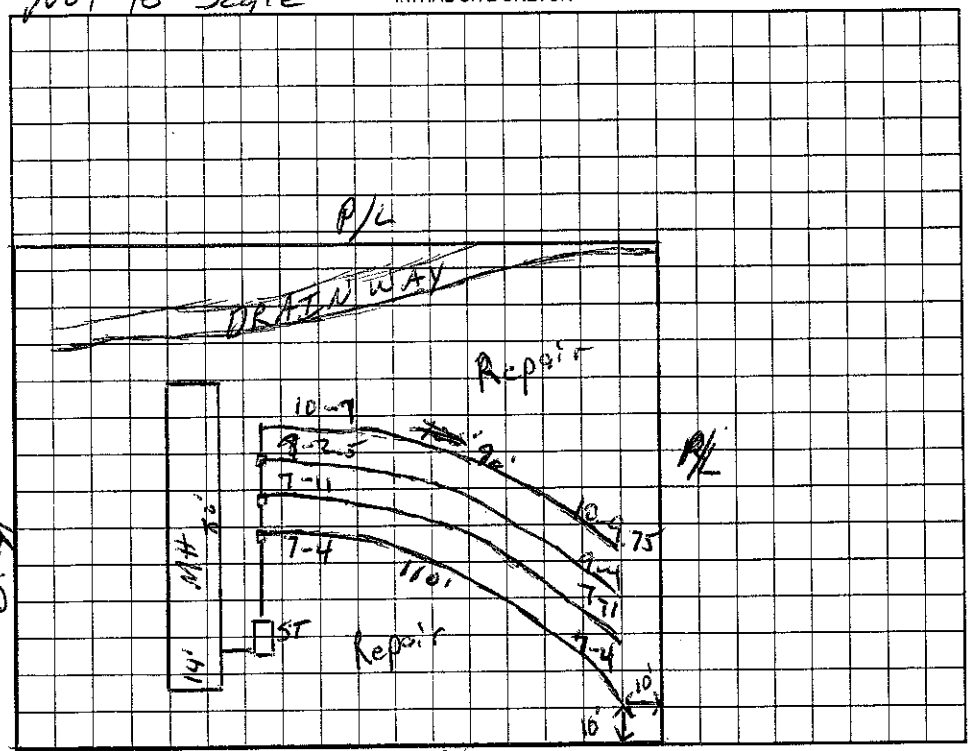


AS BUILT SKETCH

Permit can be suspended or revoked if any false information is supplied toward securing the permit/any unauthorized changes are made to the site/any unauthorized changes are made in the installation of the system. Improvement Permit with plat valid without expiration. Improvement Permit with site plan valid for sixty months. Authorization to Construct is valid for a period equal to that of Improvement Permit – not to exceed sixty months.

Signed: Richard C Lambert date

Improvement Permit by: RSI date 2/13/01

Authorization to Construct by: RSI date 2/13/01

Installed by: Brent Dalchey

Operation Permit by: Wesley Sparks RS. date 2/21/01

Existing System Inspection by: date

HEALTH DEPT. COPY: WHITE OWNER COPY (FINAL): YELLOW OWNER COPY (INITIAL): PINK