# IREDELL COUNTY HEALTH DEPARTMENT

STATESVILLE 704-878-5305 MOORESVILLE 704-664-5281

## IMPROVEMENT PERMIT / AUTHORIZATION TO CONSTRUCT / OPERATION PERMIT / EXISTING SYSTEM INSPECTION

PERMIT# 07348 3 PIN# 4740558016 DATE 6/10/98

OWNER OR CONTRACTOR PAM L. BOST PHONE: Business Home 528-0142

ADDRESS 186 LIPE RD TROUTMAN

LOCATION HWY 21/115 N- TL 1ST FLOWER HOUSE - X I77 - TL LIPE RD - ON RT NEAR END

SUBDIVISION — BLOCK / SECTION — LOT — LOT AREA .77AC SITE CLASS. PS DESIGN FLOW 360GPD L.T.A.R. .30 GPD/FT2

Septic Tank: 1000 Gallons; STB 821 Date 10/1/98
Pump Tank: Gallons; PT Date
Pump Make: Model Serial No.
Nitrification Field: No Fields 1 Square Feet 900 Linear Feet 300
No Lines 5 @ 60' Trench Width 36" Max Trench Bottom Depth 36" Gravel Depth N/A

☑ New System ☐ Repair System Type: I, II, III, IV, V, VI
System Description: GRAVITY CHAMBERS OR MS
Repair System Description: PANEL
Maintenance Agreement Required: ☐ Yes ☑ No

☑ House/Mod. Home No. Bedrooms 3
☐ Mobile Home No. Bathrooms 2
☐ Business No. Employees
☐ Other


☐ Slab ☑ Crawl Space ☐ Basement w/plumbing ☐ Basement wo/plumbing

Water Supply: ☑ Individual ☐ Public ☐ Community


Comments:/Conditions:

Comments:/Conditions:

**INITIAL SITE SKETCH**

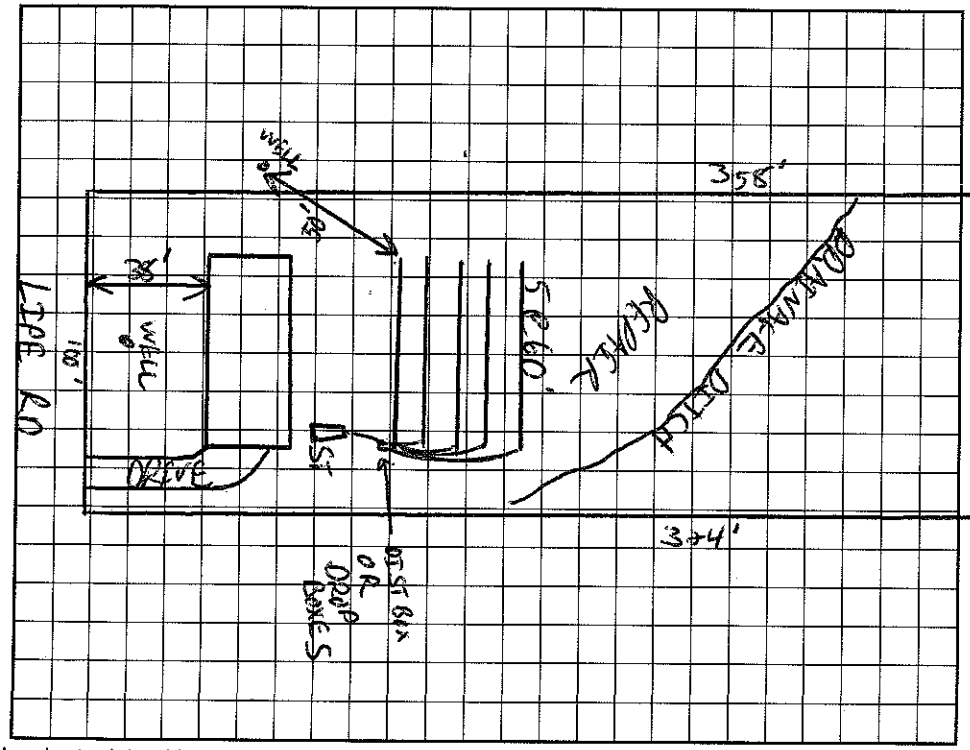


**AS BUILT SKETCH**

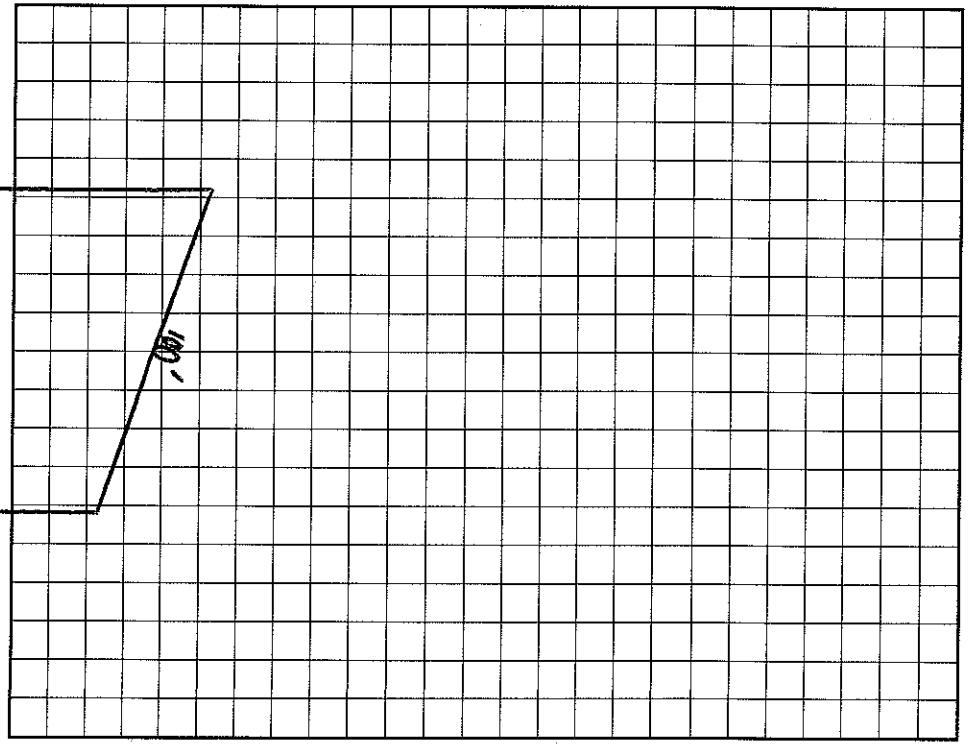


I understand that this permit can be suspended or revoked if any false information is supplied toward securing the permit/any unauthorized changes are made to the site/any unauthorized changes are made in the installation of the system. Improvement Permit with plat valid without expiration. Improvement Permit with site plan valid for sixty months. Authorization to Construct is valid for a period equal to that of Improvement Permit – not to exceed sixty months.

Signed: William Bret Howard date

Improvement Permit by: C. Ray Lee RS date 6/10/98

Authorization to Construct by: C. Ray Lee RS date 6/10/98

Installed by: D & M Enterprises

Operation Permit by: Wesley Sparks RS. date 11/12/98

Existing System Inspection by: date

HEALTH DEPT. COPY: WHITE INSPECTION COPY (FINAL): GREEN OWNER COPY (FINAL): YELLOW INSPECTION COPY (INITIAL): PINK OWNER COPY (INITIAL): GOLD