IREDELL COUNTY HEALTH DEPARTMENT

Statesville Office (704) 878-5305 Mooresville Office (704) 660-3625 PERMIT # 217060

IMPROVEMENT PERMIT / AUTHORIZATION TO CONSTRUCT / OPERATION PERMIT / EXISTING SYSTEM

PIN # 4790560726 ✓

APPLICANT: Freedom Homes APPLICANT ADDRESS: 1124 Charlotte Hwy

SITE ADDRESS: 234 Applehill Rd PHONE: 704-876-5886 ALT. PHONE: N/A

SITE DIRECTIONS: Hwy 21 to Flowerhouse Lp TR Applehill Rd Property on Right


SUBDIVISION: N/A SECTION: N/A LOT # N/A LOT AREA: 0.83acres DESIGN FLOW: 360gpd L.T.A.R.: Existing

Septic Tank	Existing	(gal)	STB		Date	☐ New System	☐ Repair	☐ Expansion	System Type: I II III IV V VI	☑ Residence	No. Bedrooms	3	Water Supply		
Pump Tank		(gal)	PT		Date	System Description:	Existing			☐ Business	No. Persons	6	☐ Private		
Pump Make		Model			Serial #	Repair System Description:				☐ Other	No. Employees		☑ Public		
# Nitrification Fields	Ex	# Lines	Ex		Linear Ft: Ex	Maintenance Agreement Required:	☐ YES	☑ NO		☐ Slab	☑ Crawl Space		☐ Community		
Trench Width	Ex	Max. Trench Bottom Depth	Ex		Gravel Depth Ex		☐ GRAVITY	☐ PRESSURE		☐ Basement w/plumbing			☐ Basement w/o plumbing		


Comments / Conditions:

- maintain a minimum of 10' between Home Foundation & all components of septic tank system & repair area.

INITIAL SITE SKETCH

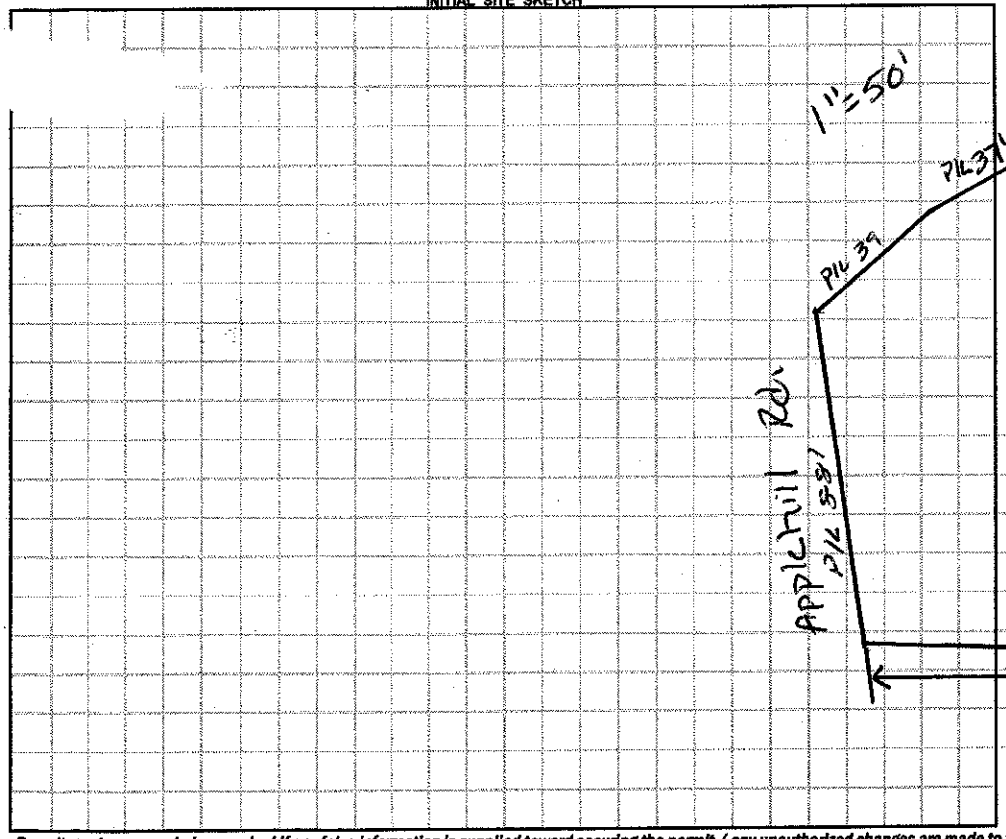

AS BUILT SKETCH

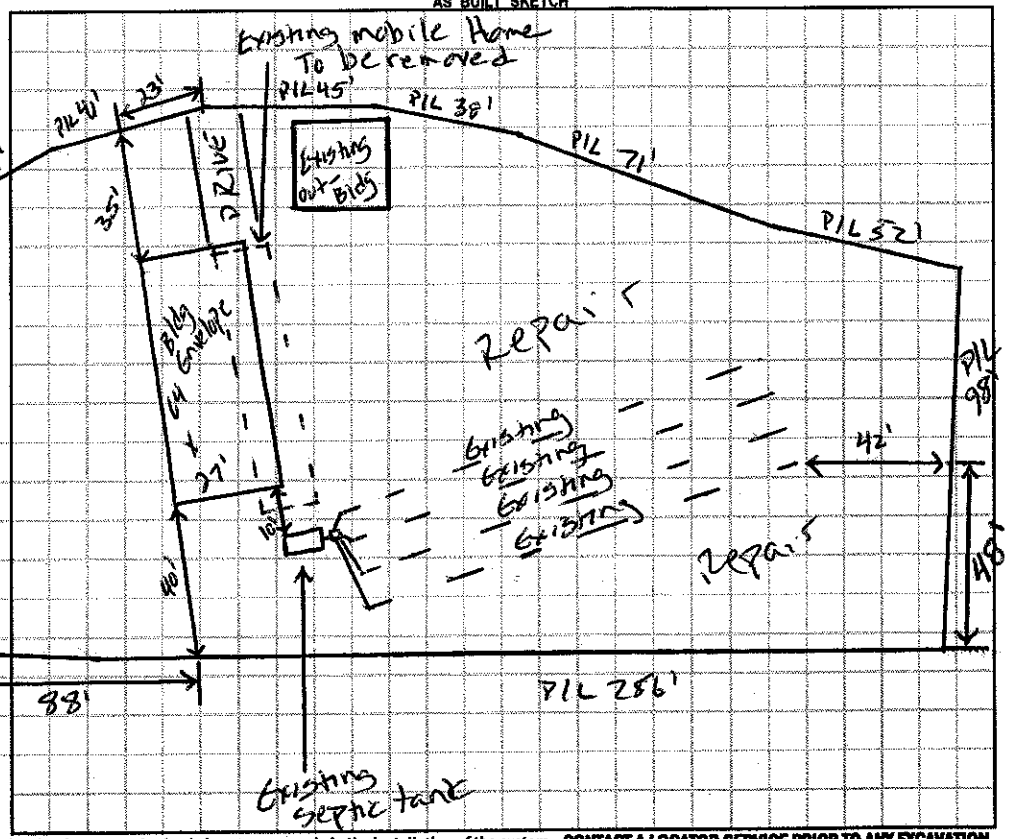

Permit can be suspended or revoked if any false information is supplied toward securing the permit / any unauthorized changes are made to the site / any unauthorized changes are made in the installation of the system. **CONTACT A LOCATOR SERVICE PRIOR TO ANY EXCAVATION**

☐ **IMPROVEMENT PERMIT** *with plat valid without expiration.* ☐ **IMPROVEMENT PERMIT** *with site plan valid for 60 mos.* ☐ **AUTHORIZATION TO CONSTRUCT** *valid for period equal to IMPROVEMENT PERMIT--not to exceed 60 mo.*

Owner / Applicant Signature: Stephen Allen Date: 4-18-16 Installed by:

IMPROVEMENT PERMIT by: Date: OPERATION PERMIT by: Date:

AUTHORIZATION TO CONSTRUCT by: Date: Existing System Inspected by: Justin Henderson Date: 4-11-16

Health Dept. Copy - WHITE Applicant (Final Approval) - YELLOW Applicant (Conditional Approval) - PINK