IREDELL COUNTY HEALTH DEPARTMENT

Authorization to Construct PIN# 4740-00-0177

STATESVILLE 704-878-5305 MOORESVILLE 704-664-5281

IMPROVEMENT PERMIT / ~~CERTIFICATE OF COMPLETION~~ / OPERATION PERMIT / EXISTING SYSTEM INSPECTION

PROPERTY DESCRIPTION NO. 23254 DATE 3/19/96 TAX MAP NO. 4F 38 9 Watershed: [X] Yes [ ] No

OWNER OR CONTRACTOR Wm. L. Carr c/o Lakeland Realty PHONE: Business 663-5592 Home

ADDRESS P.O. Box 1738 Mooresville, NC. 28115

LOCATION Carlyle Rd., 21-115 N TL 185' Flowers Home Lt. TL Carlyle Rd. on (R) a .8 mile on (R)

SUBDIVISION Carlyle Farms BLOCK / SECTION 1 LOT 9 LOT AREA .58 Ac SITE CLASS PS DESIGN FLOW 360 L.T.A.R. .3

Septic Tank: 1000 Gallons; STB 821 Date 3500 ASI

Pump Tank: Gallons; PT Date

Pump Make: Model Serial No.

Nitrification Field: No Fields 1 Square Feet 1200 Linear Feet 400

No Lines 5 Trench Width 36" Max Trench Bottom Depth 36" Gravel Depth 12"

[X] New System [ ] Repair System Type: I (II) III IV V VI

System Description: Gravity Conventional

Repair System Description: Same

Maintenance Agreement Required: [ ] Yes [ ] No

[X] House/Mod. Home No. Bedrooms 3

[ ] Mobile Home No. Bathrooms 2

[ ] Business No. Employees

[ ] Other


[ ] Slab [X] Crawl Space [ ] Basement w/plumbing [ ] Basement wo/plumbing

Water Supply: [X] Individual [ ] Community [ ] Public


Comments: Trailer site may not be cut down - foundation must be built up in order to avoid pumping to drainfield.

Comments:

INITIAL SITE SKETCH

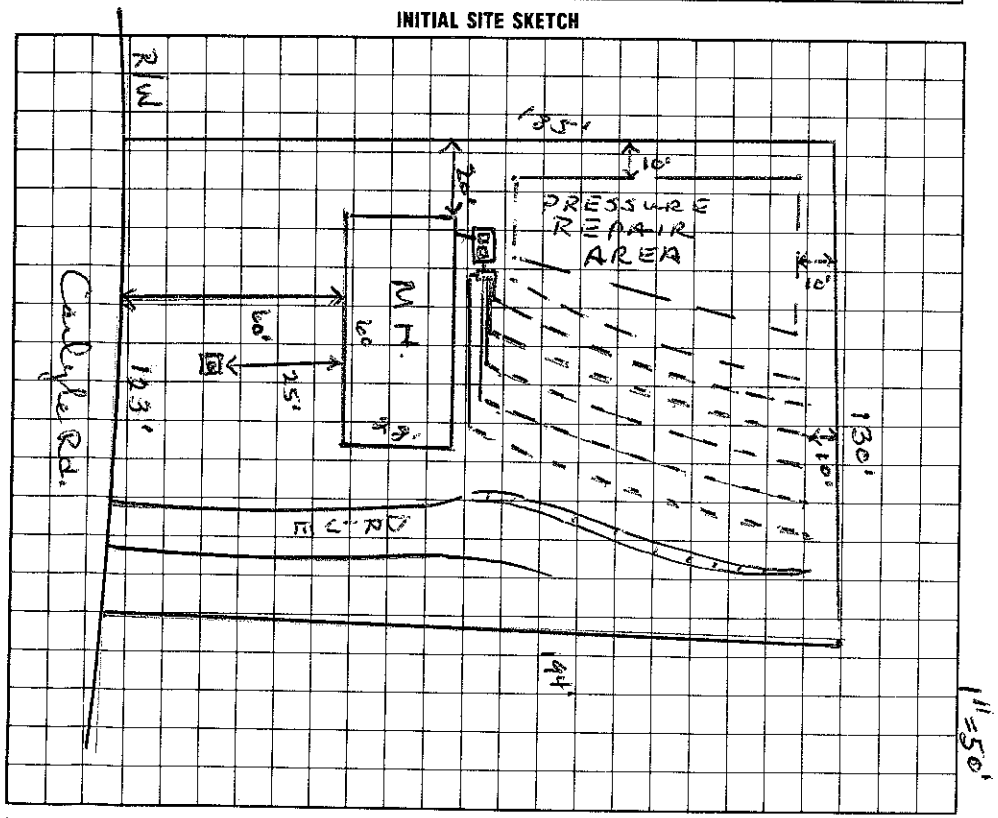

AS BUILT SKETCH

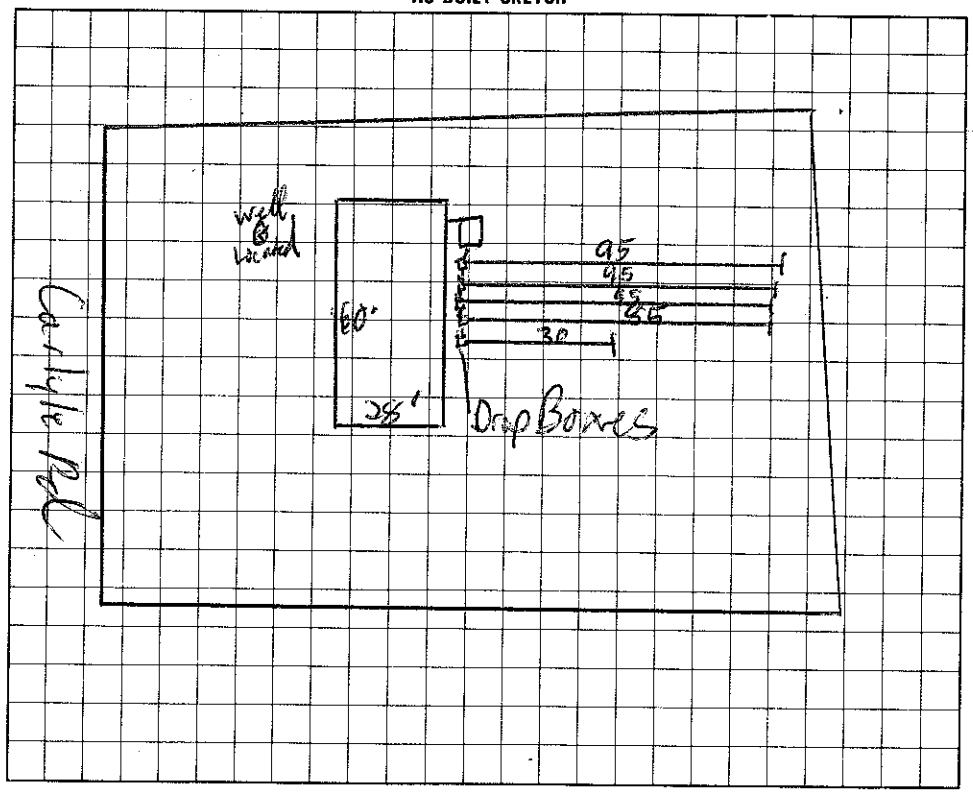

I understand that this permit can be suspended or revoked if any false information is supplied toward securing the permit/any unauthorized changes are made to the site/any unauthorized changes are made in the installation of the system.

Authorization to Construct valid for 5 years.

Signed Brenda B Ulyssevich

Improvement Permit by: Wesley Sparks R.S. date 3/19/96

Existing System Inspection by: Contract Wesley Sparks R.S. date 3/19/96

Installed by: West Lincoln Grading

Certificate of Completion by: date

Operation Permit by: C. Brady Thomas EHST date 4/15/96

HEALTH DEPT. COPY: WHITE INSPECTION COPY (FINAL): GREEN OWNER COPY (FINAL): YELLOW INSPECTION COPY (INITIAL): PINK OWNER COPY (INITIAL): GOLD