1:30

IREDELL COUNTY HEALTH DEPARTMENT

STATESVILLE 704-878-5305 MOORESVILLE 704-664-5281

IMPROVEMENT PERMIT / AUTHORIZATION TO CONSTRUCT / OPERATION PERMIT / EXISTING SYSTEM INSPECTION

PERMIT# 083392 PIN# 4740 60 7544 DATE 11/2/99

OWNER OR CONTRACTOR North Lake Lumber Co. - J Patrick Frazer PHONE: Business 528-4503 Home

ADDRESS PO Box 668 Mooresville, NC. 28115

LOCATION Flower House Loop, 115 N TL 1st loop X I77 TL continue past bldg TL to behind last large bldg

SUBDIVISION No BLOCK / SECTION LOT LOT AREA SITE CLASS. DESIGN FLOW L.T.A.R.

Septic Tank: 1000 Gallons; STB 1012 Date 7/20/99
Pump Tank: Gallons; PT Date
Pump Make: Model Serial No.
Nitrification Field: No Fields 1 Square Feet 800 Linear Feet 267
No Lines 3 at 90 Trench Width 36" Max Trench Bottom Depth 36" Gravel Depth 12"

☒ New System ☐ Repair System Type: I, (II) III, IV, V, VI
System Description: GRAV CONVENTIONAL
Repair System Description:
Maintenance Agreement Required: ☐ Yes ☒ No

☐ House/Mod. Home No. Bedrooms 2
☒ Mobile Home No. Bathrooms 2
☐ Business No. Employees
☒ Other CARETAKER


☒ Slab ☒ Crawl Space ☐ Basement w/plumbing ☐ Basement wo/plumbing

Water Supply:
☒ Individual
☐ Public
☐ Community


Comments:/Conditions:

Comments:/Conditions: Riser & filter installed
Installed as drawn.

INITIAL SITE SKETCH

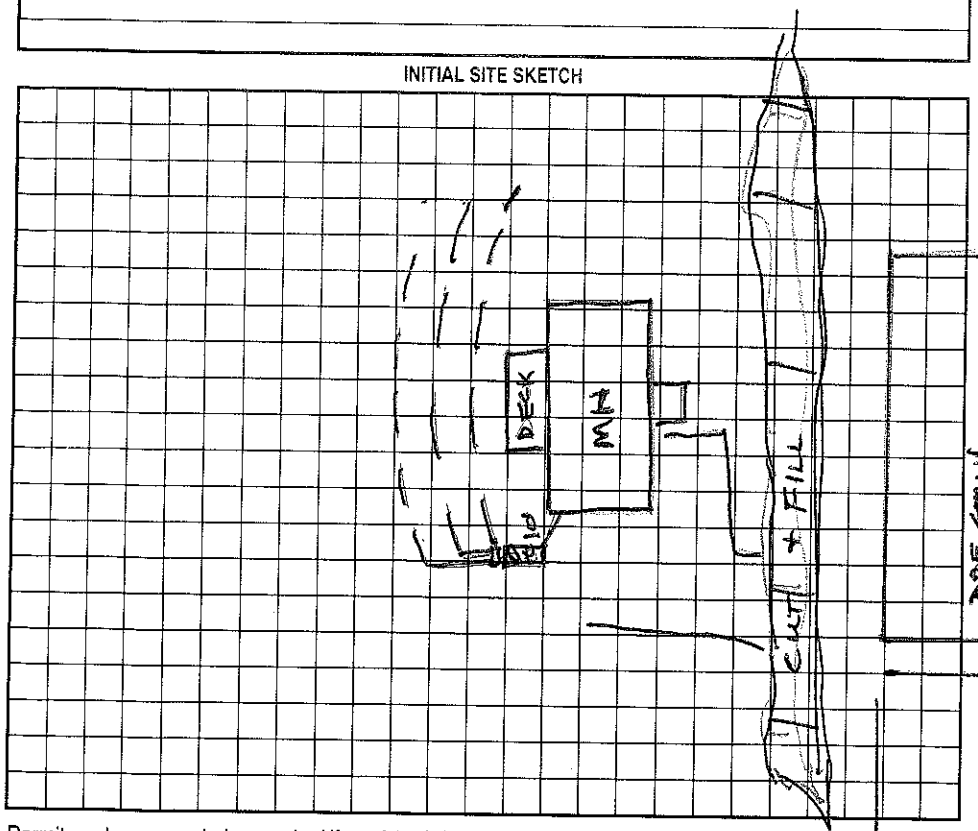

AS BUILT SKETCH

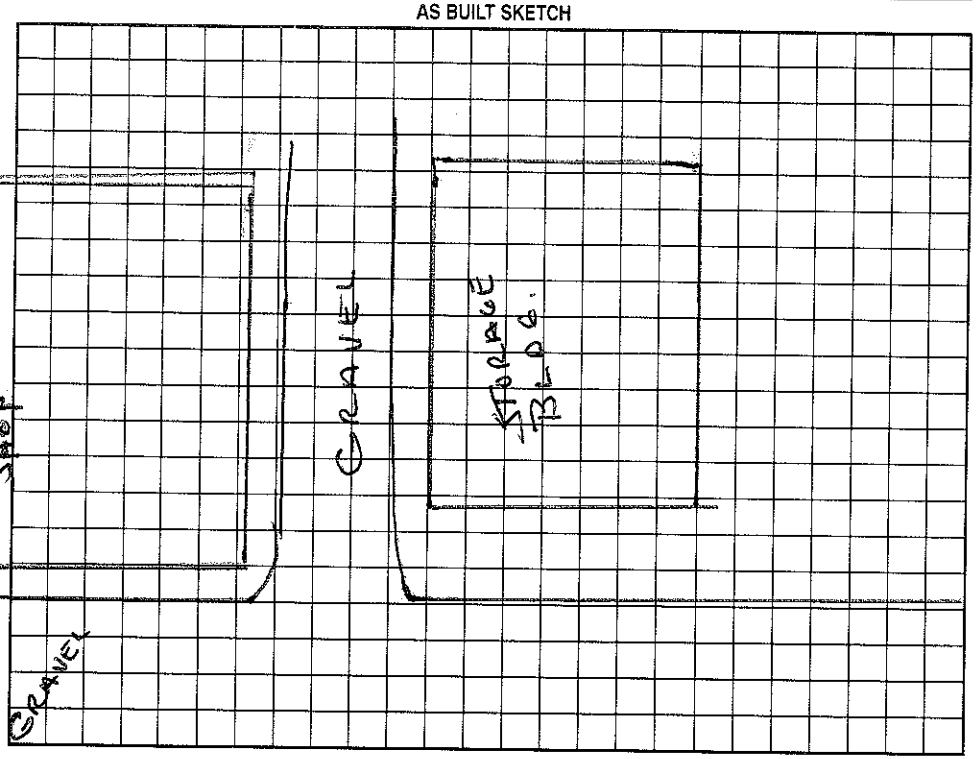

Permit can be suspended or revoked if any false information is supplied toward securing the permit/any unauthorized changes are made to the site/any unauthorized changes are made in the installation of the system. Improvement Permit with plat valid without expiration. Improvement Permit with site plan valid for sixty months. Authorization to Construct is valid for a period equal to that of Improvement Permit – not to exceed sixty months.

Signed: [signature] date 11-4-99
Improvement Permit by: Wesley Sparks R.S. date 11/2/99
Authorization to Construct by: Wesley Sparks R.S. date 11/2/99

Installed by: Piedmont Backhoe
Operation Permit by: Marvin H. Dotson R.S. date 11/9/99
Existing System Inspection by: date

HEALTH DEPT. COPY: WHITE OWNER COPY (FINAL): YELLOW OWNER COPY (INITIAL): PINK