(1030

IREDELL COUNTY HEALTH DEPARTMENT

STATESVILLE 704-878-5305 MOORESVILLE 704-664-5281

IMPROVEMENT PERMIT / AUTHORIZATION TO CONSTRUCT / OPERATION PERMIT / EXISTING SYSTEM INSPECTION

PERMIT# 070751 PIN# 4740 60 7544 DATE 12/23/97

OWNER OR CONTRACTOR [redacted] JOHN FRAZER PHONE: Business 664-6511 Home

ADDRESS 1135 QUEENSGATE - GASTONIA

LOCATION 21 N TL 1st FLOWER HOUSE LOOP - ON LT PAST I77

SUBDIVISION — BLOCK / SECTION — LOT — LOT AREA 37.92 AC SITE CLASS. RS DESIGN FLOW 625 L.T.A.R. ~.35

Septic Tank: 1500 Gallons; STB 1011 Date 2/29/98
Pump Tank: Gallons; PT Date
Pump Make: Model Serial No.
Nitrification Field: No Fields 1 Square Feet 1755 Linear Feet 585
No Lines 6 Trench Width 36" Max Trench Bottom Depth 36" Gravel Depth 12"

☑ New System ☐ Repair System Type: I, II, III, IV, V, VI
System Description: GRAVITY CONVENTIONAL
Repair System Description: SAME
Maintenance Agreement Required: ☐ Yes ☑ No

☐ House/Mod. Home No. Bedrooms
☐ Mobile Home No. Bathrooms
☑ Business No. Employees 25
☐ Other


☑ Slab ☐ Crawl Space ☐ Basement w/plumbing ☐ Basement wo/plumbing

Water Supply: ☑ Individual ☐ Public ☐ Community


Comments:/Conditions:

Comments:/Conditions:

INITIAL SITE SKETCH (NOT TO SCALE)

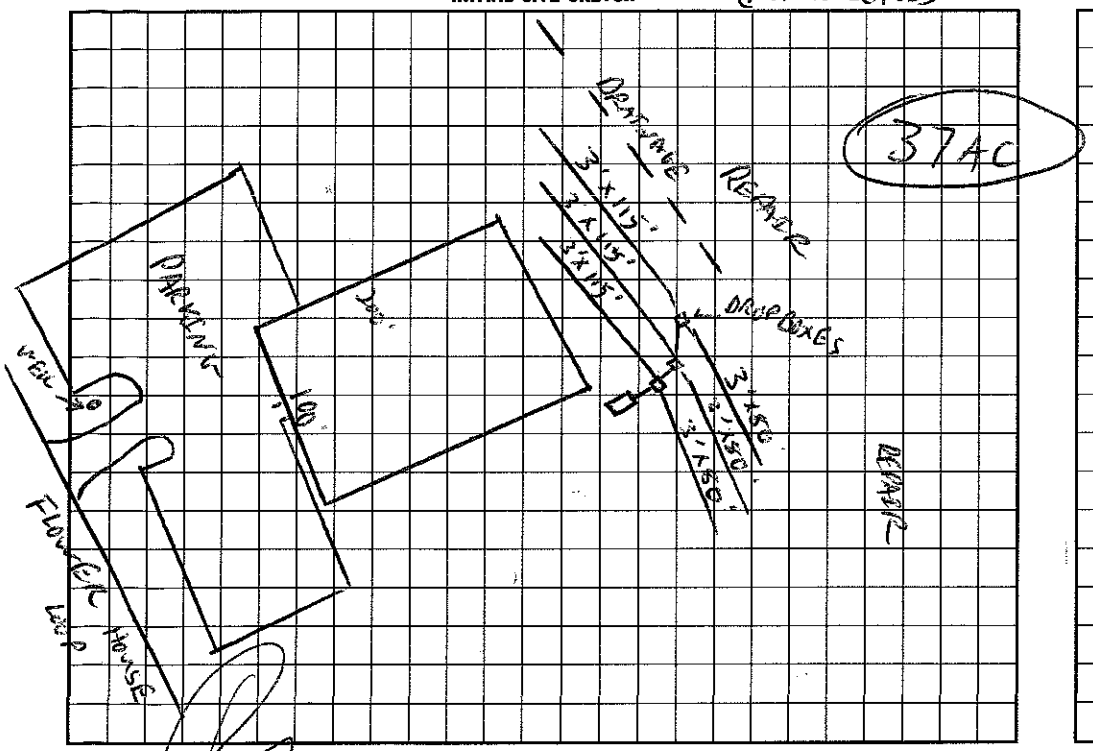

AS BUILT SKETCH

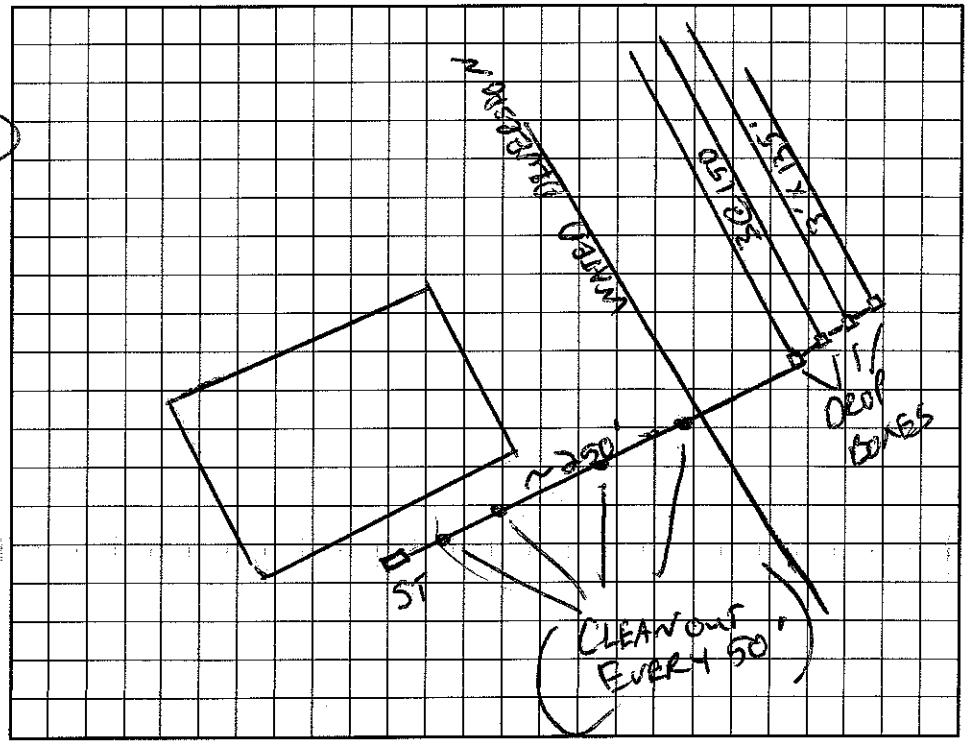

I understand that this permit can be suspended or revoked if any false information is supplied toward securing the permit/any unauthorized changes are made to the site/any unauthorized changes are made in the installation of the system. Improvement Permit with plat valid without expiration. Improvement Permit with site plan valid for sixty months. Authorization to Construct is valid for a period equal to that of Improvement Permit – not to exceed sixty months.

Signed: [signature] date

Improvement Permit by: C. Ray Zoon date 12/23/97

Authorization to Construct by: C. Ray Zoon date 12/23/97

Installed by: PIEDMONT BACKHOE - STEVE JORDAN [redacted]

Operation Permit by: C. Ray Zoon RS date 6/2/98

Existing System Inspection by: date

HEALTH DEPT. COPY: WHITE INSPECTION COPY (FINAL): GREEN OWNER COPY (FINAL): YELLOW INSPECTION COPY (INITIAL): PINK OWNER COPY (INITIAL): GOLD