IREDELL COUNTY HEALTH DEPARTMENT

STATESVILLE 704-878-5305 MOORESVILLE 704-664-5281

IMPROVEMENT PERMIT / AUTHORIZATION TO CONSTRUCT / OPERATION PERMIT / EXISTING SYSTEM INSPECTION

PERMIT# Repairs PIN# 4740016823 DATE 8/4/05

OWNER OR CONTRACTOR Jack Gryder PHONE: Business Home 704 528 4036

ADDRESS 362 Flowerhouse Fm Trout Run NC 28166

LOCATION 115 N, TL 1st Flowerhouse, on Lt Past Carlyle Hwy 62

SUBDIVISION BLOCK / SECTION LOT LOT AREA SITE CLASS. PS DESIGN FLOW 360 L.T.A.R. —

Septic Tank: 1000 Gallons; STB 1007 Date 6/17/05

Pump Tank: Gallons; PT Date

Pump Make: Model Serial No.

Nitrification Field: No Fields 1 Square Feet 1050 Linear Feet 350

No Lines 4 Trench Width 36" Max Trench Bottom Depth 36" Gravel Depth 12"

☐ New System ☒ Repair System Type: I (II) III IV V VI

System Description:

Repair System Description: Gravity Conventional

Maintenance Agreement Required: ☐ Yes ☒ No

☒ House/Mod. Home No. Bedrooms 3

☐ Mobile Home No. Bathrooms

☐ Business No. Employees

☐ Other


☐ Slab ☒ Crawl Space ☐ Basement w/plumbing ☐ Basement wo/plumbing

Water Supply: ☒ Individual ☐ Public ☐ Community

Comments:/Conditions:

Comments:/Conditions:

INITIAL SITE SKETCH

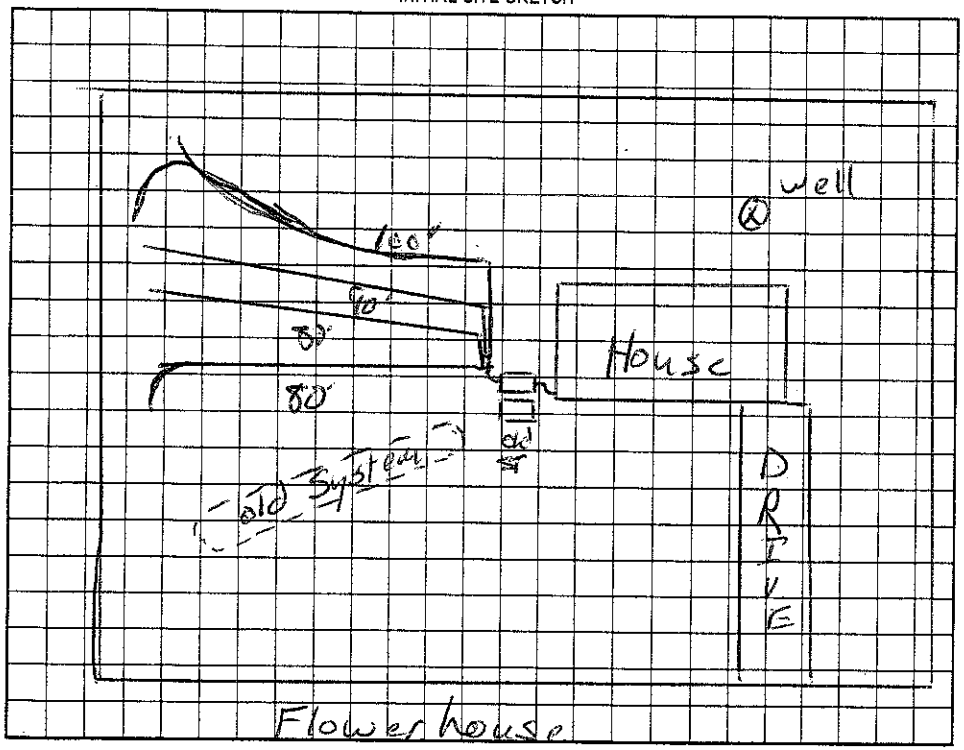

AS BUILT SKETCH

Installed As Drawn

Permit can be suspended or revoked if any false information is supplied toward securing the permit/any unauthorized changes are made to the site/any unauthorized changes are made in the installation of the system. Improvement Permit with plat valid without expiration. Improvement Permit with site plan valid for sixty months. Authorization to Construct is valid for a period equal to that of Improvement Permit – not to exceed sixty months.

Signed: Jack Gryder date 8/4/05

Improvement Permit by: RS date 8/4/05

Authorization to Construct by: RS date 8/4/05

Installed by: James Hindler

Operation Permit by: RS date 8/9/05

Existing System Inspection by: date

HEALTH DEPT. COPY: WHITE OWNER COPY (FINAL): YELLOW OWNER COPY (INITIAL): PINK