IREDELL COUNTY HEALTH DEPARTMENT

IMPROVEMENT PERMIT / ~~CERTIFICATE OF COMPLETION~~ / OPERATION PERMIT / EXISTING SYSTEM INSPECTION

Authorization to Construct

STATESVILLE 704-878-5305 MOORESVILLE 704-664-5281

1 of 2

PROPERTY DESCRIPTION NO. 067279 DATE 6/10/97 TAX MAP NO. 4740627049

OWNER OR CONTRACTOR Timothy Destryer PHONE: Business Home 528-0924

ADDRESS 350 Flower House Loop Troutman NC 28166 Watershed: ☐ Yes ☒ No

LOCATION Flower House Loop - on (L) just past Carlyle Rd.

SUBDIVISION BLOCK / SECTION LOT LOT AREA SITE CLASS. DESIGN FLOW L.T.A.R.

Septic Tank: 2 poly Gallons; STB Date

Pump Tank: Gallons; PT Date

Pump Make: Model Serial No.

Nitrification Field: No Fields 1 Square Feet 765 Linear Feet 255

No Lines 3 Trench Width 36" Max Trench Bottom Depth 36" Gravel Depth 12"

☐ New System ☒ Repair System Type: I, II, (III), IV, V, VI

System Description: FLOW DIVIDER - CONVENTIONAL

Repair System Description:

Maintenance Agreement Required: ☐ Yes ☒ No

☒ House/Mod. Home ☐ Mobile Home ☐ Business ☐ Other

No. Bedrooms 4 No. Bathrooms 3 No. Employees


☐ Slab ☒ Crawl Space ☐ Basement w/plumbing ☐ Basement wo/plumbing

Water Supply: ☒ Individual ☐ Community ☐ Public

Comments:

CARLYLE RD.

INITIAL SITE SKETCH

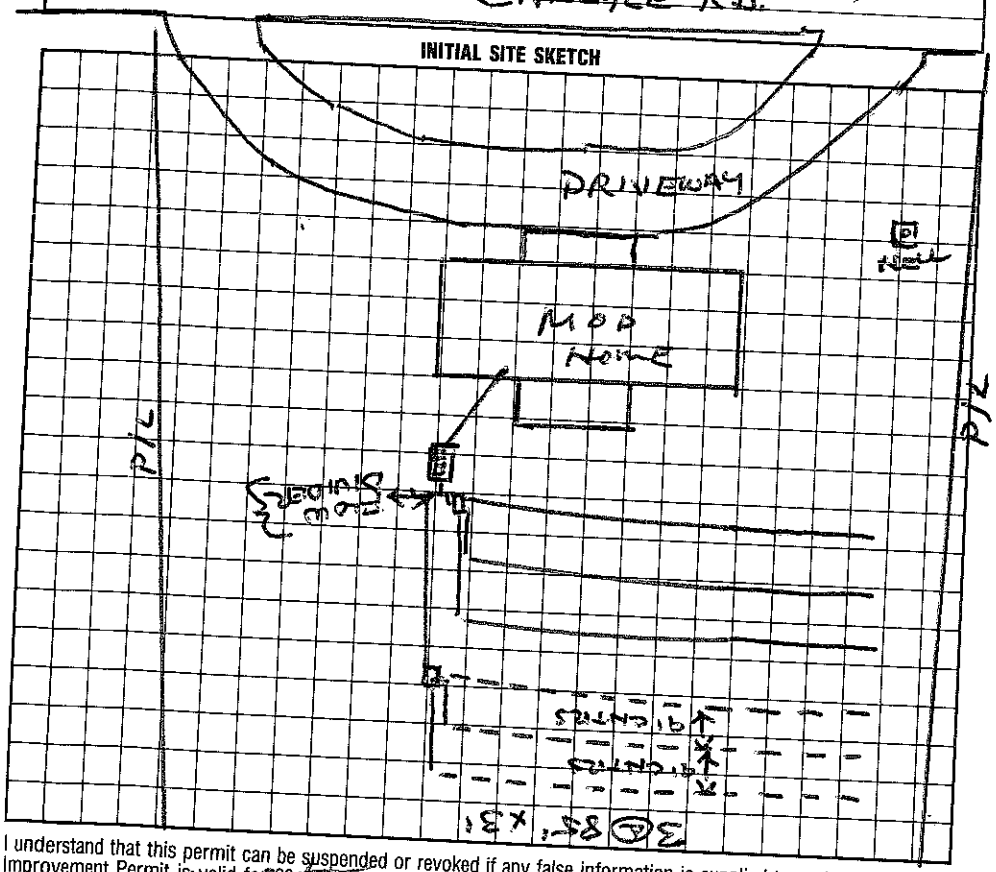

Comments:

Installed as shown here

AS BUILT SKETCH

I understand that this permit can be suspended or revoked if any false information is supplied toward securing the permit/any unauthorized changes are made to the site/any unauthorized changes are made in the installation of the system. Improvement Permit is valid for 60 months from date of issuance.

Signed: X Tim Destryer

Improvement Permit by: Wesley Sparks R.S. date 6/10/97

Existing System Inspection by: Wesley Sparks R.S. date 6/10/97

Installed by: James Huddleston

Certificate of Completion by: Wesley Sparks R.S. date 8/20/97

Operation Permit by: Wesley Sparks R.S. date 8/20/97

HEALTH DEPT. COPY: WHITE INSPECTION COPY (FINAL): GREEN OWNER COPY (FINAL): YELLOW INSPECTION COPY (INITIAL): PINK