IREDELL COUNTY HEALTH DEPARTMENT

STATESVILLE 704-878-5305 (E) MOORESVILLE 704-664-5281

IMPROVEMENT PERMIT / AUTHORIZATION TO CONSTRUCT / OPERATION PERMIT / EXISTING SYSTEM INSPECTION

PERMIT# 095208 PIN# 4740-62-2354 4740 62 8438 DATE 4/5/01

OWNER OR CONTRACTOR Richy Lynn Lipe PHONE: Business Home 704-528-6829

ADDRESS 324 Flower House Lp. Troutman, NC. 28166

LOCATION 115-21N TL 1st Flowerhouse Lp. on (L) B 4 County Hill Rd.

SUBDIVISION No BLOCK / SECTION LOT LOT AREA ~15.75 SITE CLASS. PS DESIGN FLOW 360 L.T.A.R. .3

Septic Tank: 1000 Gallons; STB 1012 Date 12/23/00

Pump Tank: Gallons; PT Date

Pump Make: Model Serial No.

Nitrification Field: No Fields 1 Square Feet 1200 Linear Feet 400

No Lines 4@100' Trench Width 3' Max Trench Bottom Depth 36" Gravel Depth 12"

☒ New System ☐ Repair System Type: I II III IV, V, VI

System Description: GRAV. CONVENTIONAL

Repair System Description: Type 3 CONVENTIONAL

Maintenance Agreement Required: ☐ Yes ☒ No

☒ House/Mod. Home ☐ Mobile Home ☐ Business ☐ Other


No. Bedrooms 3 No. Bathrooms 2 No. Employees

☐ Slab ☒ Crawl Space ☐ Basement w/plumbing ☐ Basement wo/plumbing

Water Supply: ☒ Individual ☐ Public ☐ Community

Comments/Conditions: PRESSURE REPAIR

INITIAL SITE SKETCH

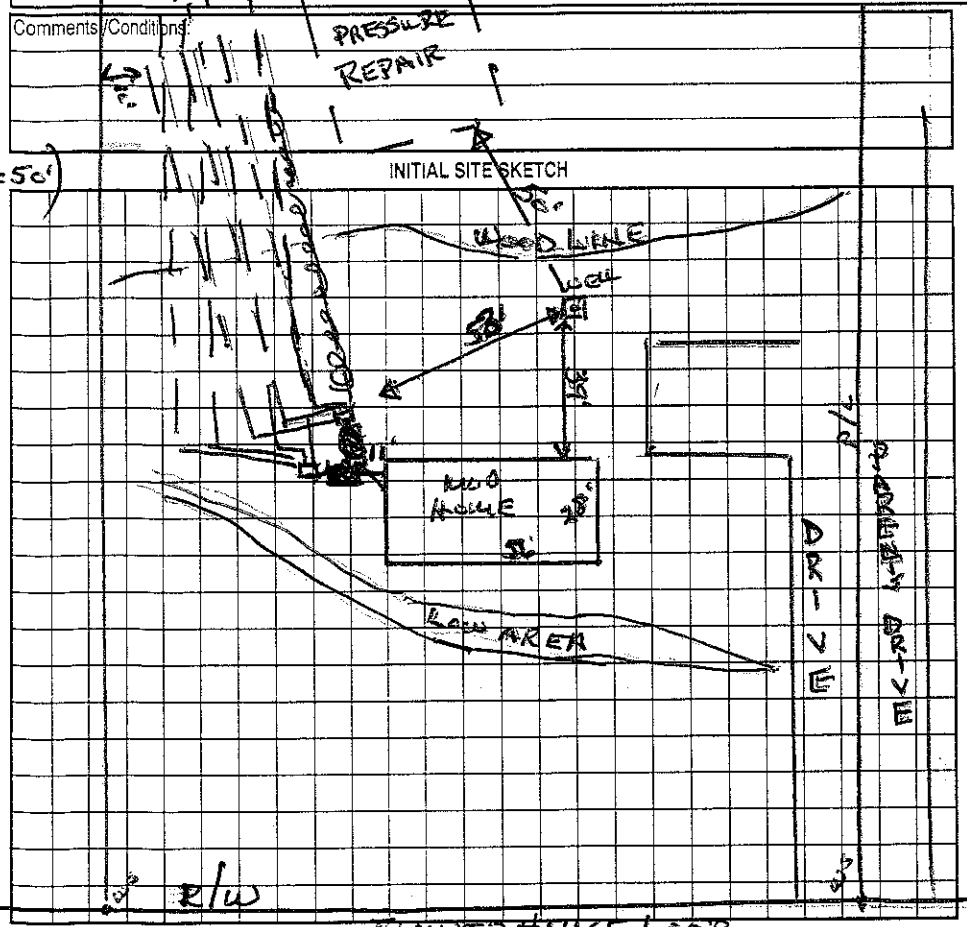

Comments/Conditions:

AS BUILT SKETCH

Permit can be suspended or revoked if any false information is supplied toward securing the permit/any unauthorized changes are made to the site/any unauthorized changes are made in the installation of the system. Improvement Permit with plat valid without expiration. Improvement Permit with site plan valid for sixty months. Authorization to Construct is valid for a period equal to that of Improvement Permit – not to exceed sixty months.

Signed: JoAnn Cook date 04/06/01 Installed by: Statesville Backhoe

Improvement Permit by: Wesley Sparks R.S. date 4/5/01 Operation Permit by: Wesley Sparks R.S. date 4/29/01

Authorization to Construct by: Wesley Sparks R.S. date 4/5/01 Existing System Inspection by: date

HEALTH DEPT. COPY: WHITE OWNER COPY (FINAL): YELLOW OWNER COPY (INITIAL): PINK