IREDELL COUNTY HEALTH DEPARTMENT

STATESVILLE 704-878-5305 MOORESVILLE 704-664-5281

IMPROVEMENT PERMIT / AUTHORIZATION TO CONSTRUCT / OPERATION PERMIT / EXISTING SYSTEM INSPECTION

PERMIT# 128867 PIN# 4740-63-2078 DATE 7/11/05

OWNER OR CONTRACTOR Clifford Godfrey PHONE: Business Home 704-528-9857

ADDRESS 156 Clontz Hill Rd. Troutman NC 28166

LOCATION 115N, TL Flowershouse, TL Clontz Hill ≈ 900 ft on Lt.

SUBDIVISION BLOCK / SECTION LOT LOT AREA 1.064 Ac SITE CLASS. PS DESIGN FLOW 360 L.T.A.R. 0.3

Septic Tank: 1000 Gallons; STB 312 Date 9/18/05
Pump Tank: Gallons; PT Date
Pump Make: Model Serial No.
Nitrification Field: No Fields 1 Square Feet 1200 Linear Feet 400
No Lines 3@133' Trench Width 36" Max Trench Bottom Depth 36" Gravel Depth 12"

☒ New System ☐ Repair System Type: I, (II) III, IV, V, VI
System Description: Gravity Conventional
Repair System Description: 25% Reduction
Maintenance Agreement Required: ☐ Yes ☒ No


☒ House/Mod. Home No. Bedrooms 3
☐ Mobile Home No. Bathrooms
☐ Business No. Employees
☐ Other
☐ Slab ☒ Crawl Space ☐ Basement w/plumbing ☐ Basement wo/plumbing

Water Supply: ☒ Individual ☐ Public ☐ Community

Comments:/Conditions:

Comments:/Conditions: ST W/ RISERS AND RPD POLY LOK FILTER INSTALLED AS DRAWN

INITIAL SITE SKETCH

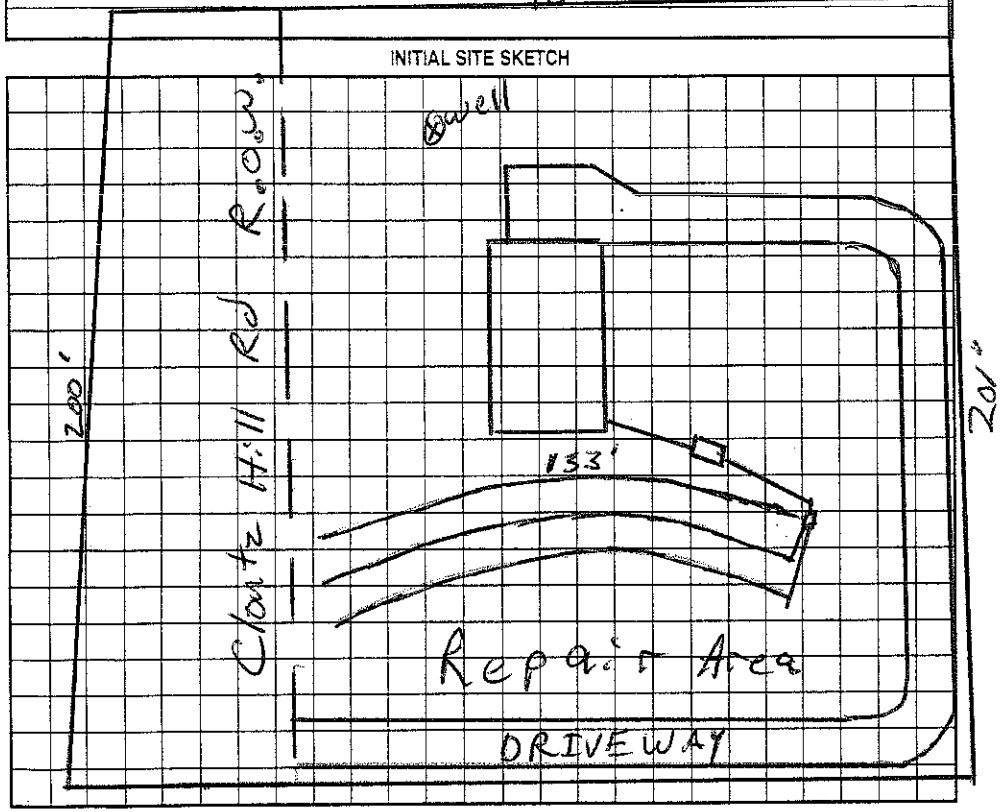

AS BUILT SKETCH

Permit can be suspended or revoked if any false information is supplied toward securing the permit/any unauthorized changes are made to the site/any unauthorized changes are made in the installation of the system. Improvement Permit with plat valid without expiration. Improvement Permit with site plan valid for sixty months. Authorization to Construct is valid for a period equal to that of Improvement Permit – not to exceed sixty months.

Signed: Ray Bream date 8/8/05 Installed by: RAY BEAM

Improvement Permit by: RS date 7/11/05 Operation Permit by: date 10/27/05

Authorization to Construct by: RS date 7/11/05 Existing System Inspection by: date

HEALTH DEPT. COPY: WHITE OWNER COPY (FINAL): YELLOW OWNER COPY (INITIAL): PINK