IREDELL COUNTY HEALTH DEPARTMENT

STATESVILLE 704-878-5305 155.00 Pg. 9 MOORESVILLE 704-664-[illegible]

IMPROVEMENT PERMIT / AUTHORIZATION TO CONSTRUCT / OPERATION PERMIT / EXISTING SYSTEM INSPECTION

PERMIT# 100285 PIN# [illegible] 4740 63 3486 DATE 4/21/03

OWNER OR CONTRACTOR J D Powell PHONE: Business 704-662-8436 Home

ADDRESS 140 J Cloontz Hill Rd Trentmen NC. 28166 / 140 Cloontz Hill Rd.

LOCATION Flowers Home Lp. TL Cloontz Hill Rd. 3 BR dwlg on (R) to end of drive

SUBDIVISION No BLOCK / SECTION LOT LOT AREA ~ 1.08 Ac SITE CLASS. PS DESIGN FLOW 3 L.T.A.R. .3

Septic Tank: 1000 Gallons; STB 1012 Date 03/03/03

Pump Tank: 1000 Gallons; PT 19 Date 9/25/02

Pump Make: Model Serial No.

Nitrification Field: No Fields 1 Square Feet USE EXISTING

No Lines D Rem Width FIELD Max Trench Bottom Depth Gravel Depth

☒ New System ☐ Repair System Type: I, II, (III), IV, V, VI

System Description: ST PT Pump+Supply Line

Repair System Description: Type 3

Maintenance Agreement Required: ☐ Yes ☒ No

☒ House/Mod. Home No. Bedrooms 3

☐ Mobile Home No. Bathrooms 2

☐ Business No. Employees

☐ Other


☐ Slab ☒ Crawl Space ☐ Basement w/plumbing ☐ Basement wo/plumbing

Water Supply: ☒ Individual ☐ Public ☐ Community


Comments:/Conditions:

Comments:/Conditions:

INITIAL SITE SKETCH

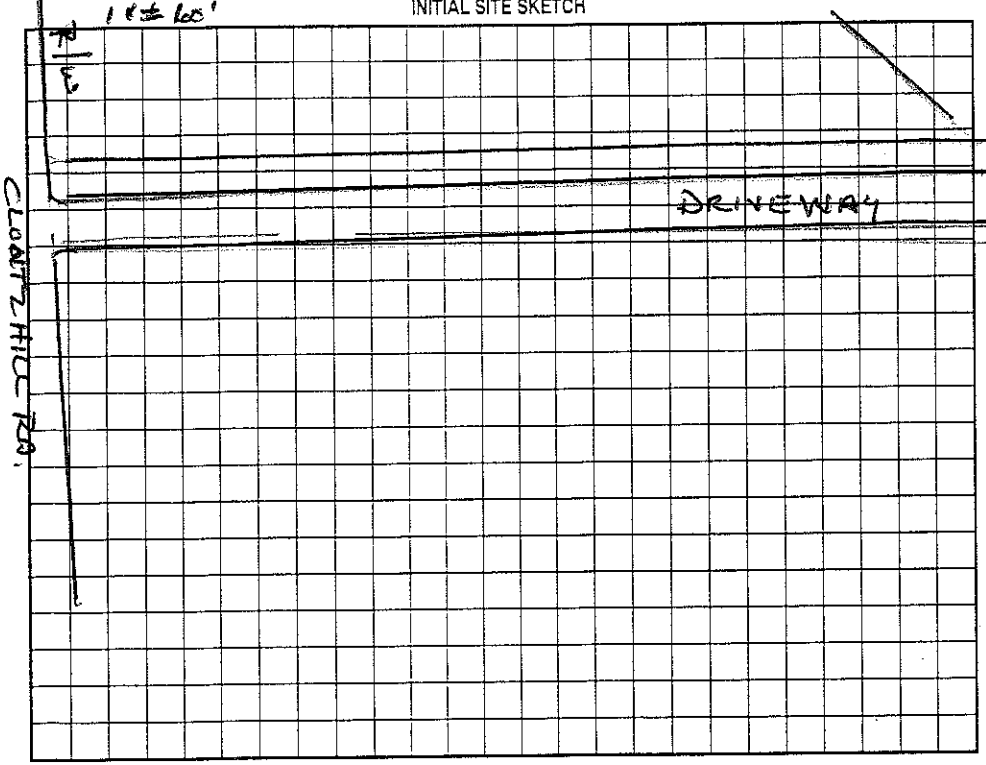

AS BUILT SKETCH

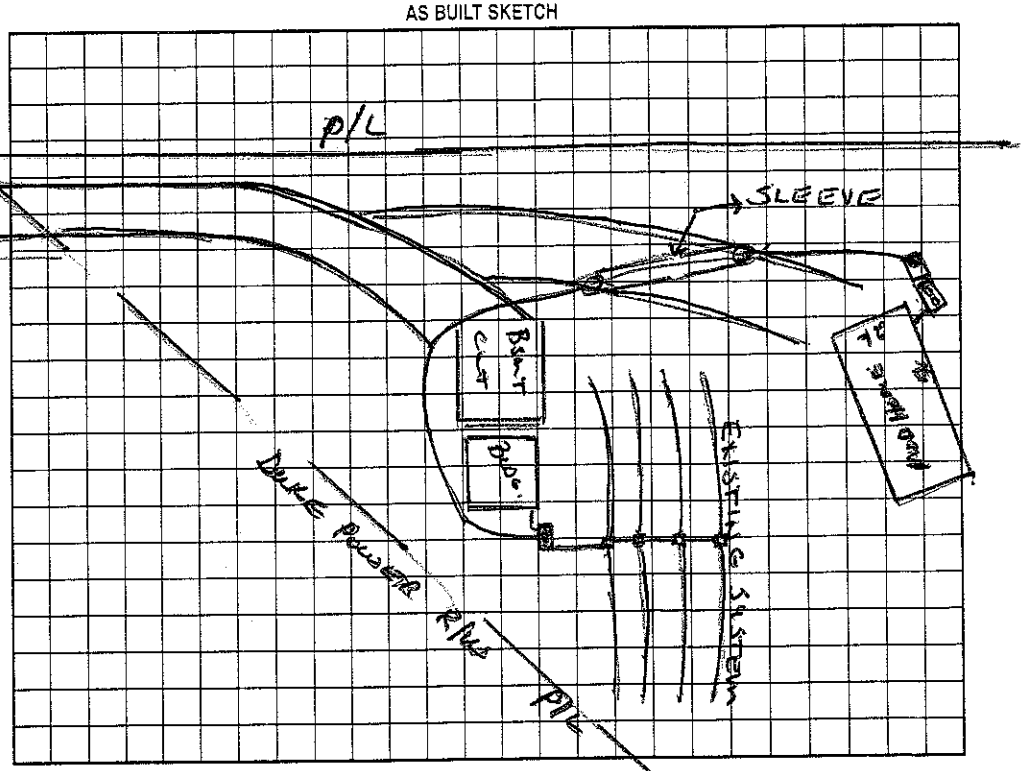

Permit can be suspended or revoked if any false information is supplied toward securing the permit/any unauthorized changes are made to the site/any unauthorized changes are made in the installation of the system. Improvement Permit with plat valid without expiration. Improvement Permit with ~~site plan~~ valid for sixty months. Authorization to Construct is valid for a period equal to that of Improvement Permit – not to exceed sixty months.

Signed: x Dennis Gallion date

Improvement Permit by: Wesley Sparks RS date 4/21/03

Authorization to Construct by: Wesley Sparks RS date 4/21/03

Installed by: A-1 Backhoe

Operation Permit by: Wesley Sparks RS. date 6/26/03

Existing System Inspection by: date

HEALTH DEPT. COPY: WHITE OWNER COPY (FINAL): YELLOW OWNER COPY (INITIAL): PINK