IREDELL COUNTY HEALTH DEPARTMENT

STATESVILLE 704-878-5305 MOORESVILLE 704-664-5281

IMPROVEMENT PERMIT / AUTHORIZATION TO CONSTRUCT / OPERATION PERMIT / EXISTING SYSTEM INSPECTION

PERMIT# 128731 PIN# 4740-66-6182 DATE 5/23/05

OWNER OR CONTRACTOR Lewis Gregory PHONE: Business _____ Home _____

ADDRESS 155 Apple Hill Dr. Troutman NC 28166

LOCATION 115/21 N, TR Flower house Lp, turn Apple Hill, on Lt #155

SUBDIVISION _____ BLOCK / SECTION _____ LOT _____ LOT AREA 0.352A SITE CLASS. PS DESIGN FLOW 360 L.T.A.R. _____

Septic Tank: ~~New~~ Exist. Gallons; STB _____ Date _____

Pump Tank: _____ Gallons; PT _____ Date _____

Pump Make: _____ Model _____ Serial No. _____

Nitrification Field: No Fields ____ Square Feet _____ Linear Feet _____

No Lines _____ Trench Width _____ Max Trench Bottom Depth _____ Gravel Depth _____

☐ New System ☐ Repair System Type: I, II, III, IV, V, VI

System Description: Exist. Conventional Bed

Repair System Description: _____

Maintenance Agreement Required: ☐ Yes ☐ No

☐ House/Mod. Home ☒ Mobile Home ☐ Business ☐ Other

No. Bedrooms ____ No. Bathrooms 3 No. Employees ____

☐ Slab ☐ Crawl Space ☐ Basement w/plumbing ☐ Basement wo/plumbing


Water Supply: ☒ Individual ☐ Public ☐ Community

Comments:/Conditions: 3bedroom SW-MH burned – Replacing with 2bedroom MH

Comments:/Conditions:

INITIAL SITE SKETCH

AS BUILT SKETCH

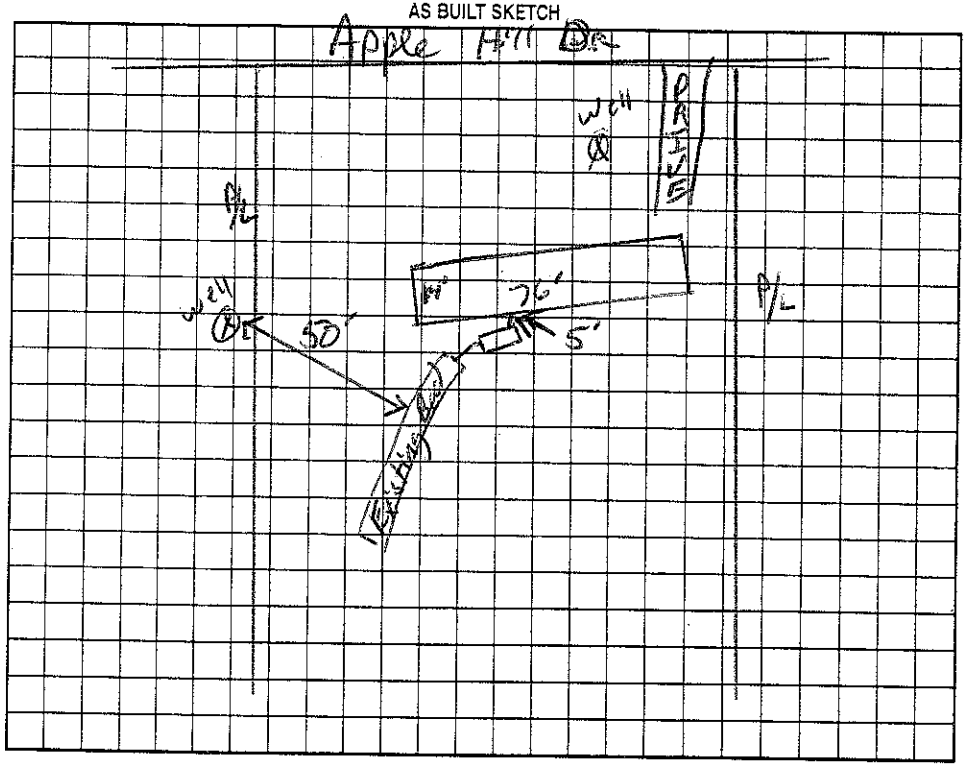

Permit can be suspended or revoked if any false information is supplied toward securing the permit/any unauthorized changes are made to the site/any unauthorized changes are made in the installation of the system. Improvement Permit with plat valid without expiration. Improvement Permit with site plan valid for sixty months. Authorization to Construct is valid for a period equal to that of Improvement Permit – not to exceed sixty months.

Signed: Lewis Gregory date 5/24/05 Installed by: _____

Improvement Permit by: _____ date _____ Operation Permit by: _____ date _____

Authorization to Construct by: _____ date _____ Existing System Inspection by: _____ date 5/23/05

HEALTH DEPT. COPY: WHITE OWNER COPY (FINAL): YELLOW OWNER COPY (INITIAL): PINK