IREDELL COUNTY HEALTH DEPARTMENT

Authorization to Construct

STATESVILLE 704-878-5305 | MOORESVILLE 704-664-5281

4740683412

IMPROVEMENT PERMIT / ~~CERTIFICATE OF COMPLETION~~ / OPERATION PERMIT / EXISTING SYSTEM INSPECTION

PROPERTY DESCRIPTION NO. 23182 DATE 5/3/96 TAX MAP NO. 4E-A-4 pt of Watershed: ☑ Yes ☐ No

OWNER OR CONTRACTOR Chris Lipe PHONE: Business _____ Home 878-6926

ADDRESS 176 Beaverbrook Rd Stat. NC 28677

LOCATION - 21/155, TR Barkdale Rd - 600' on Rt.

SUBDIVISION — BLOCK / SECTION — LOT — LOT AREA 1ac SITE CLASS. PS DESIGN FLOW 240gpd L.T.A.R. .3 gpd/ft2

Septic Tank: 1000 Gallons; STB 821 Date 6/14/96

Pump Tank: _____ Gallons; PT _____ Date _____

Pump Make: _____ Model _____ Serial No. _____

Nitrification Field: No Fields 1 Square Feet 810 Linear Feet 270

No Lines 3 Trench Width 36" Max Trench Bottom Depth 36" Gravel Depth 12"

☑ New System ☐ Repair System Type: I (II) III. IV. V. VI

System Description: Gravity Conventional / Chamber

Repair System Description: _____

Maintenance Agreement Required: ☐ Yes ☑ No

☐ House/Mod. Home No. Bedrooms 2

☑ Mobile Home No. Bathrooms 2

☐ Business No. Employees _____

☐ Other _____


☐ Slab ☑ Crawl Space ☐ Basement w/plumbing ☐ Basement wo/plumbing

Water Supply: ☑ Individual ☐ Community ☐ Public

Comments:

Comments:

INITIAL SITE SKETCH

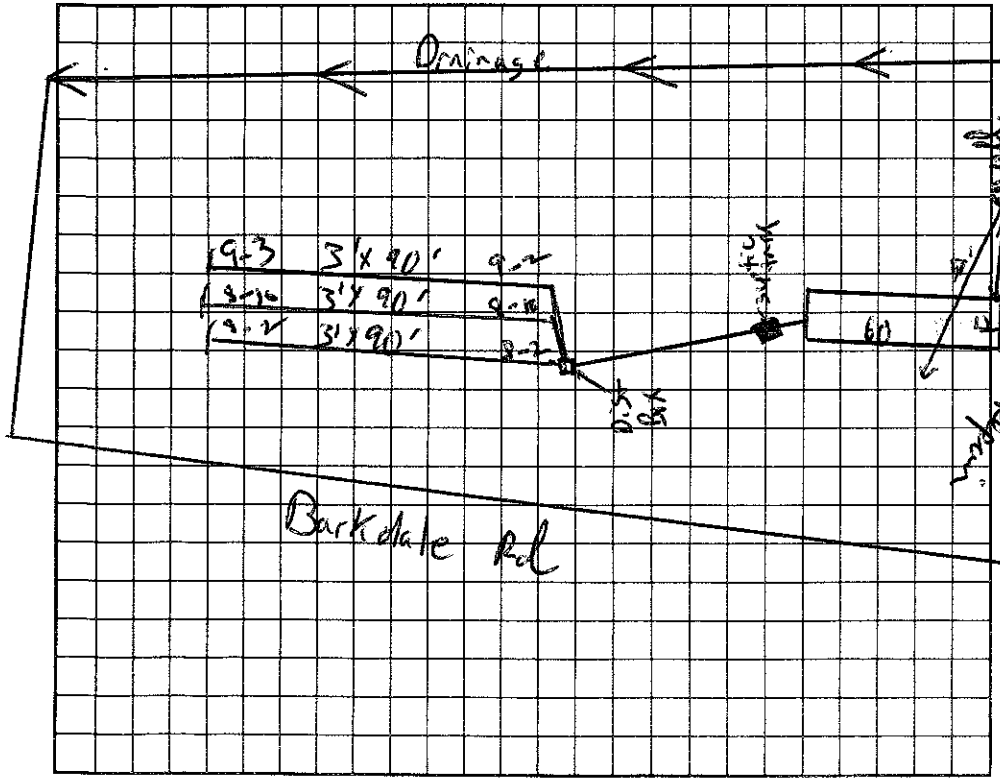

AS BUILT SKETCH

I understand that this permit can be suspended or revoked if any false information is supplied toward securing the permit/any unauthorized changes are made to the site/any unauthorized changes are made in the installation of the system.

Signed: Vernell E. Lipe

Installed by: G+M Contracting

Improvement Permit by: C. Bobbitt EHSE date 5/3/96

Authorization to Construct

~~Existing System Inspection by:~~ C. Bobbitt EHSI date 5/3/96

Certificate of Completion by: _____ date _____

Operation Permit by: Wesley Parker R.S. date 7/17/96

HEALTH DEPT. COPY: WHITE | INSPECTION COPY (FINAL): GREEN | OWNER COPY (FINAL): YELLOW | INSPECTION COPY (INITIAL): PINK | OWNER COPY (INITIAL): GOLD

Authorization to Construct is valid for 60 months from issue date