IREDELL COUNTY HEALTH DEPARTMENT

STATESVILLE 704-878-5305 MOORESVILLE 704-664-5281

IMPROVEMENT PERMIT / AUTHORIZATION TO CONSTRUCT / OPERATION PERMIT / EXISTING SYSTEM INSPECTION

PERMIT# 77858 PIN# 4740688037 DATE 12-1-98

OWNER OR CONTRACTOR PS West Construction PHONE: Business 873 4325 Home

ADDRESS 431 S. center St Statesville

LOCATION 21 S below Troutman TR Parkside Tr Caporate Dr. 300' Rt

SUBDIVISION Troutman Bluff BLOCK / SECTION LOT 3 LOT AREA 1 acre SITE CLASS PS DESIGN FLOW 200 L.T.A.R. .125

Septic Tank: 1000 Gallons; STB Date

Pump Tank: Gallons; PT Date

Pump Make: Model Serial No.

Nitrification Field: No Fields 1 Square Feet 900 Linear Feet 300

No Lines 6 Trench Width 36" Max Trench Bottom Depth 36" Gravel Depth 12"

☑ New System ☐ Repair System Type: I, II, III, IV, V, VI

System Description: Conv. Gravity

Repair System Description: " "

Maintenance Agreement Required: ☐ Yes ☑ No

☐ House/Mod. Home ☐ Mobile Home ☑ Business ☐ Other

No. Bedrooms 4 No. Bathrooms 4 No. Employees

☑ Slab ☐ Crawl Space ☐ Basement w/plumbing ☐ Basement wo/plumbing


Water Supply: ☑ Individual ☐ Public ☐ Community

Comments:/Conditions:


Comments:/Conditions:

* Note: Tank switched to opposite ~~side~~ corner of Bldg per Jack Moore

INITIAL SITE SKETCH

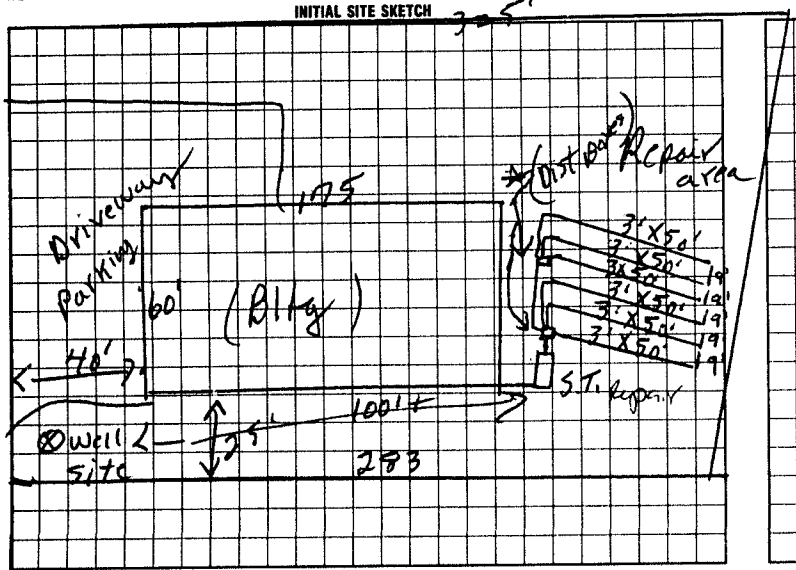

AS BUILT SKETCH

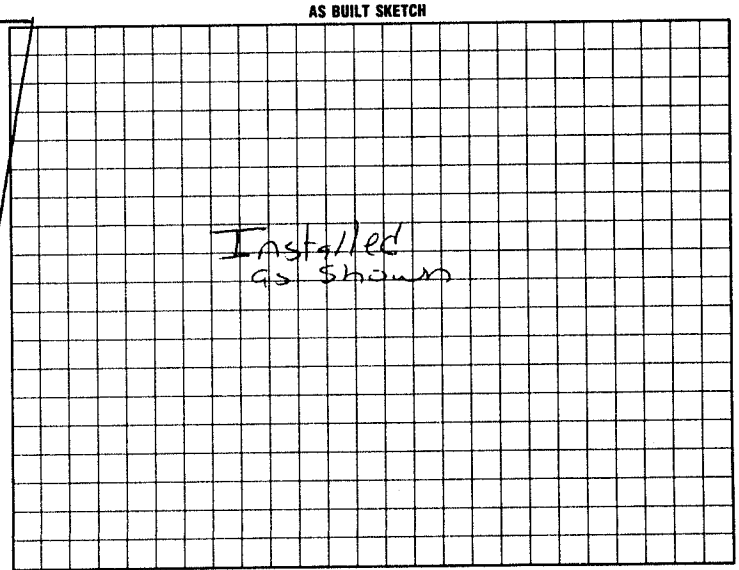

I understand that this permit can be suspended or revoked if any false information is supplied toward securing the permit/any unauthorized changes are made to the site/any unauthorized changes are made in the installation of the system. Improvement Permit with plat valid without expiration. Improvement Permit with site plan valid for sixty months. Authorization to Construct is valid for a period equal to that of Improvement Permit – not to exceed sixty months.

Signed: William Buell date

Improvement Permit by: E.C. Moore date 12-1-98

Authorization to Construct by: E.C. Moore date 12-1-98

Installed by: JC Backhoe Service

Operation Permit by: Maf date 8-13-99

Existing System Inspection by: date

HEALTH DEPT COPY: WHITE INSPECTION COPY (FINAL): GREEN OWNER COPY (FINAL): YELLOW INSPECTION COPY (INITIAL): PINK OWNER COPY (INITIAL): GOLD