IREDELL COUNTY HEALTH DEPARTMENT

STATESVILLE 704-878-5305 MOORESVILLE 704-664-5281

IMPROVEMENT PERMIT / AUTHORIZATION TO CONSTRUCT / OPERATION PERMIT / EXISTING SYSTEM INSPECTION

PERMIT# 079435 PIN# 4740 71 1734 DATE 3/17/99

OWNER OR CONTRACTOR Harold L. Hailey PHONE: Business Home 528-6222

ADDRESS 379 Flower House Loop. Troutman, NC. 28166

LOCATION 115-21N TL 1st Flower House Loop, X 87 TR 1st drive on (R), (L) on new drive to Mod. location

SUBDIVISION NO BLOCK / SECTION LOT LOT AREA 5.59AC SITE CLASS PS DESIGN FLOW 360 L.T.A.R. .3

Septic Tank: 1000 Gallons; STB Date

Pump Tank: Gallons; PT Date

Pump Make: Model Serial No.

Nitrification Field: No Fields 1 Square Feet 1200 Linear Feet 400

No Lines 5 Trench Width 36" Max Trench Bottom Depth 32" Gravel Depth 12"

(X) New System ☐ Repair System Type: I, II, III, IV, V, VI

System Description: Gravity-Conventional

Repair System Description: None

Maintenance Agreement Required: ☐ Yes (X) No

(X) House/Mod. Home No. Bedrooms 3

☐ Mobile Home No. Bathrooms 3

☐ Business No. Employees

☐ Other


☐ Slab (X) Crawl Space ☐ Basement w/plumbing ☐ Basement w/o plumbing

Water Supply: (X) Individual ☐ Public ☐ Community

Comments:/Conditions:


(1" = 100')

INITIAL SITE SKETCH

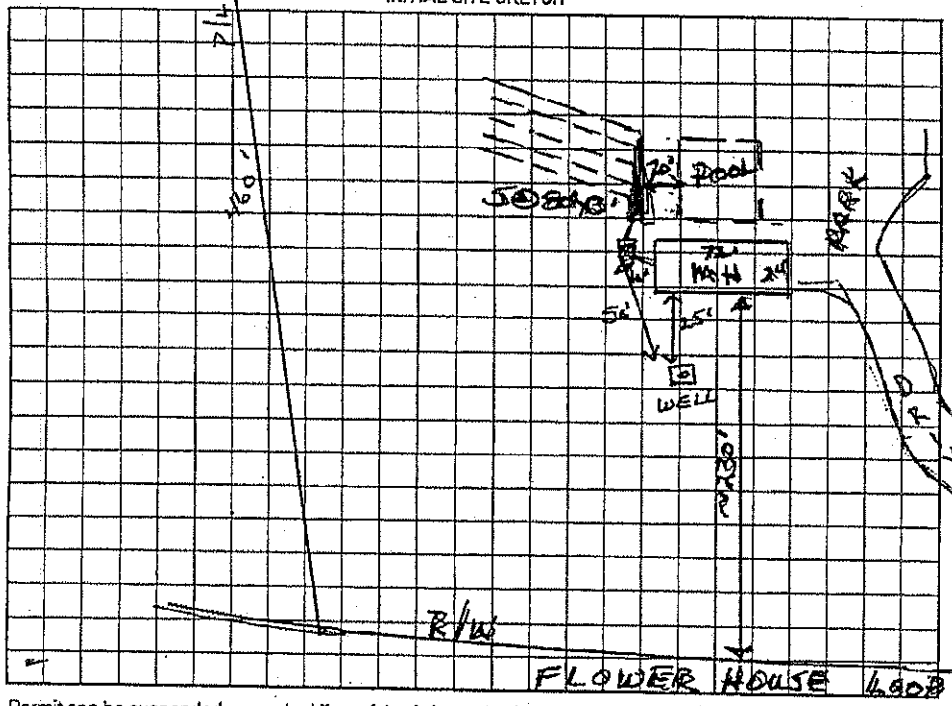

Comments:/Conditions:

AS BUILT SKETCH

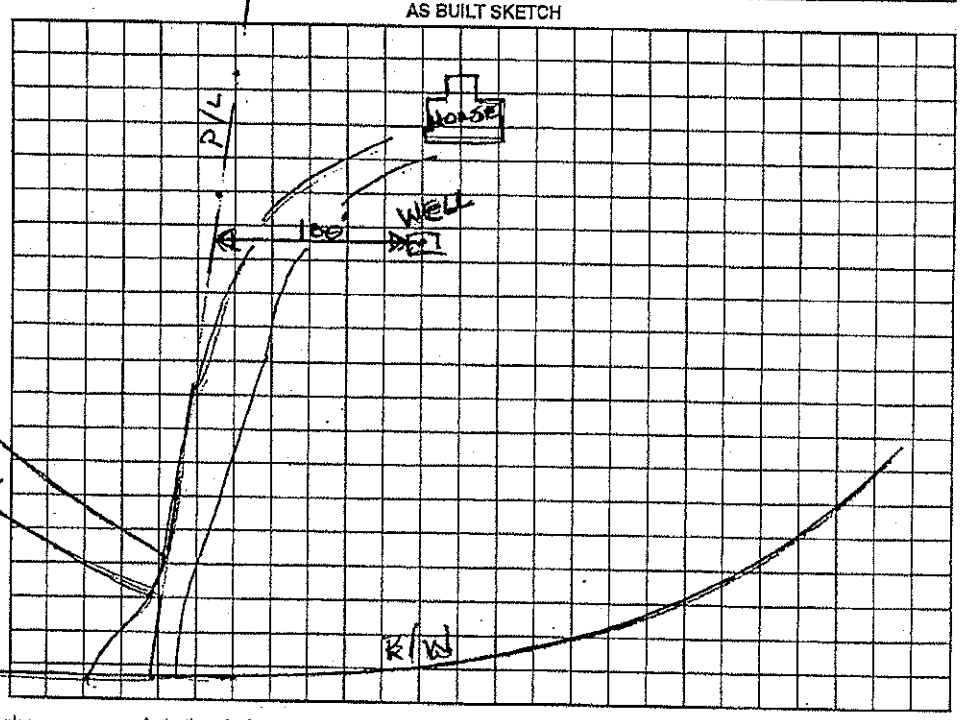

Permit can be suspended or revoked if any false information is supplied toward securing the permit/any unauthorized changes are made to the site/any unauthorized changes are made in the installation of the system. Improvement Permit with plat valid without expiration. Improvement Permit with site plan valid for sixty months. Authorization to Construct is valid for a period equal to that of Improvement Permit – not to exceed sixty months.

Signed: [signature] date 3-22-99

Improvement Permit by: Wesley Sparks RS. date 3/17/99

Authorization to Construct by: Wesley Sparks RS. date 3/17/99

Installed by:

Operation Permit by: date

Existing System Inspection by: date

HEALTH DEPT. COPY: WHITE OWNER COPY (FINAL): YELLOW OWNER COPY (INITIAL): PINK

ZONING DISCLAIMER



Property Address 351 Flowerhouse Loop Rd Troutman NC 28166

The applicant certifies that there are no deed restrictions, contractual agreements or governmental regulations of any kind that interfere with or prohibit the use of the property or the use for which this permit is requested. Applicant further acknowledges that the enforcement of deed restrictions, plat conditions, and other contractual agreements will not be undertaken by Iredell County and is the sole responsibility of the affected parties.

Applicant

4-17-2014
Date