ICHD - ENVIRONMENTAL HEALTH DIVISION

Statesville Office (704) 878-5305 Mooresville Office (704) 660-3625

SEPTIC: IMPROVEMENT PERMIT / AUTHORIZATION TO CONSTRUCT / OPERATION PERMIT / EXISTING SYSTEM

PERMIT # AP 325553

APPLICANT/OWNER: Chad Puckett

APPLICANT ADDRESS: 8257 Paytons Pointe Ln, Denver NC 28037

PIN # 4740 -- 72 -- 24.33

SITE ADDRESS: 321 Flower House Loop Troutman NC 28166

PHONE: 704-560-3517 ALT. PHONE

SITE DIRECTIONS: (N) NC 21 → (L) Flower House Loop → lot on (R)

SUBDIVISION:

SECTION: LOT # LOT AREA: 4.626 ac

SAP CONTROLLED: ☐ YES ☒ NO

DESIGN FLOW: 550 gpd L.T.A.R.: 0.275

Septic Tank 1000 (gal) STB SHAF GT-420 Date 5/13/22

Pump Tank (gal) PT Date

Pump Make Model Serial #

Nitrification Fields 1 # Lines 6 Linear Ft 500'

Trench Width 36" Trench Bottom Depth(Low side) 30' (36" max) Gravel Depth N/A

☒ New System ☐ Repair ☐ Expansion System Type: I II (III) IV V VI

System Description: 25% Reduction

Repair System Description: 50% Reduction

Maintenance Agreement Required: ☐ YES ☒ NO

☒ GRAVITY ☐ PRESSURE

☐ Residence No. Bedrooms

☒ Business No. Persons

☐ Other No. Employees 2

☒ Slab ☐ Crawl Space 1 public restrooms

☐ Basement w/plumbing ☐ Basement w/o plumbing

Water Supply: ☒ Private ☐ Public ☐ Community

Comments / Conditions: Do not pave, grade, drive, park or bury utilities in drain field. Direct drainage from septic. Keep drainlines 15' (if side slope) from diversion ditch 25' if they are upslope from ditch

Keep tank 15' or greater from storm water pipes & drains
Keep supply line ≥5' from storm water pipes & drains
Keep supply line 30" deep where it will be under pavement

INITIAL SITE SKETCH

* Traffic rated tank required if it will be subject to vehicular traffic *

See attached site plan by ICHD & Jordan Grant (surveyor) approved 5/5/22

AS BUILT SKETCH

FOR SEPTIC FINAL INSPECTION CALL: 704-664-3703 between 8am-9am the day the inspection is needed. Be sure to speak with an inspector to confirm your time.

Verify tank risers are at proper level when parking lot completed

Installed as Drawn except Line 5 = 98", Line 6 = 62'

Permit can be suspended or revoked if any false information is supplied toward securing the permit / any unauthorized changes are made to the site / any unauthorized changes are made in the installation of the system. **CONTACT A LOCATOR SERVICE PRIOR TO ANY EXCAVATION**

☐ **IMPROVEMENT PERMIT** *with plat valid without expiration.* ☒ **IMPROVEMENT PERMIT** *with site plan valid for 60 mos.* ☒ **AUTHORIZATION TO CONSTRUCT** *valid for period equal to IMPROVEMENT PERMIT--not to exceed 60 mo.*

Owner / Applicant Signature: Chad Puckett Date: 5-6-22

IMPROVEMENT PERMIT by: D. Meberg Date: 5/1/22

AUTHORIZATION TO CONSTRUCT by: D Meberg Date: 5/5/22

Installed by: Alpha Grading

OPERATION PERMIT by: [illegible] Date: 2/28/23

Existing System Inspected by: Date:

FOR SEPTIC FINAL INSPECTION: CALL 704-664-3703 between 8am-9am the day the inspection is needed.


1"=60'

321 Flower House Loop
Traitman, NC 28766


approved 5/5/22

2 employees
2 public restrooms


* Keep supply line 5' minimum from drainage pipes & fences & future building. Future building site must be marked to sign OP.

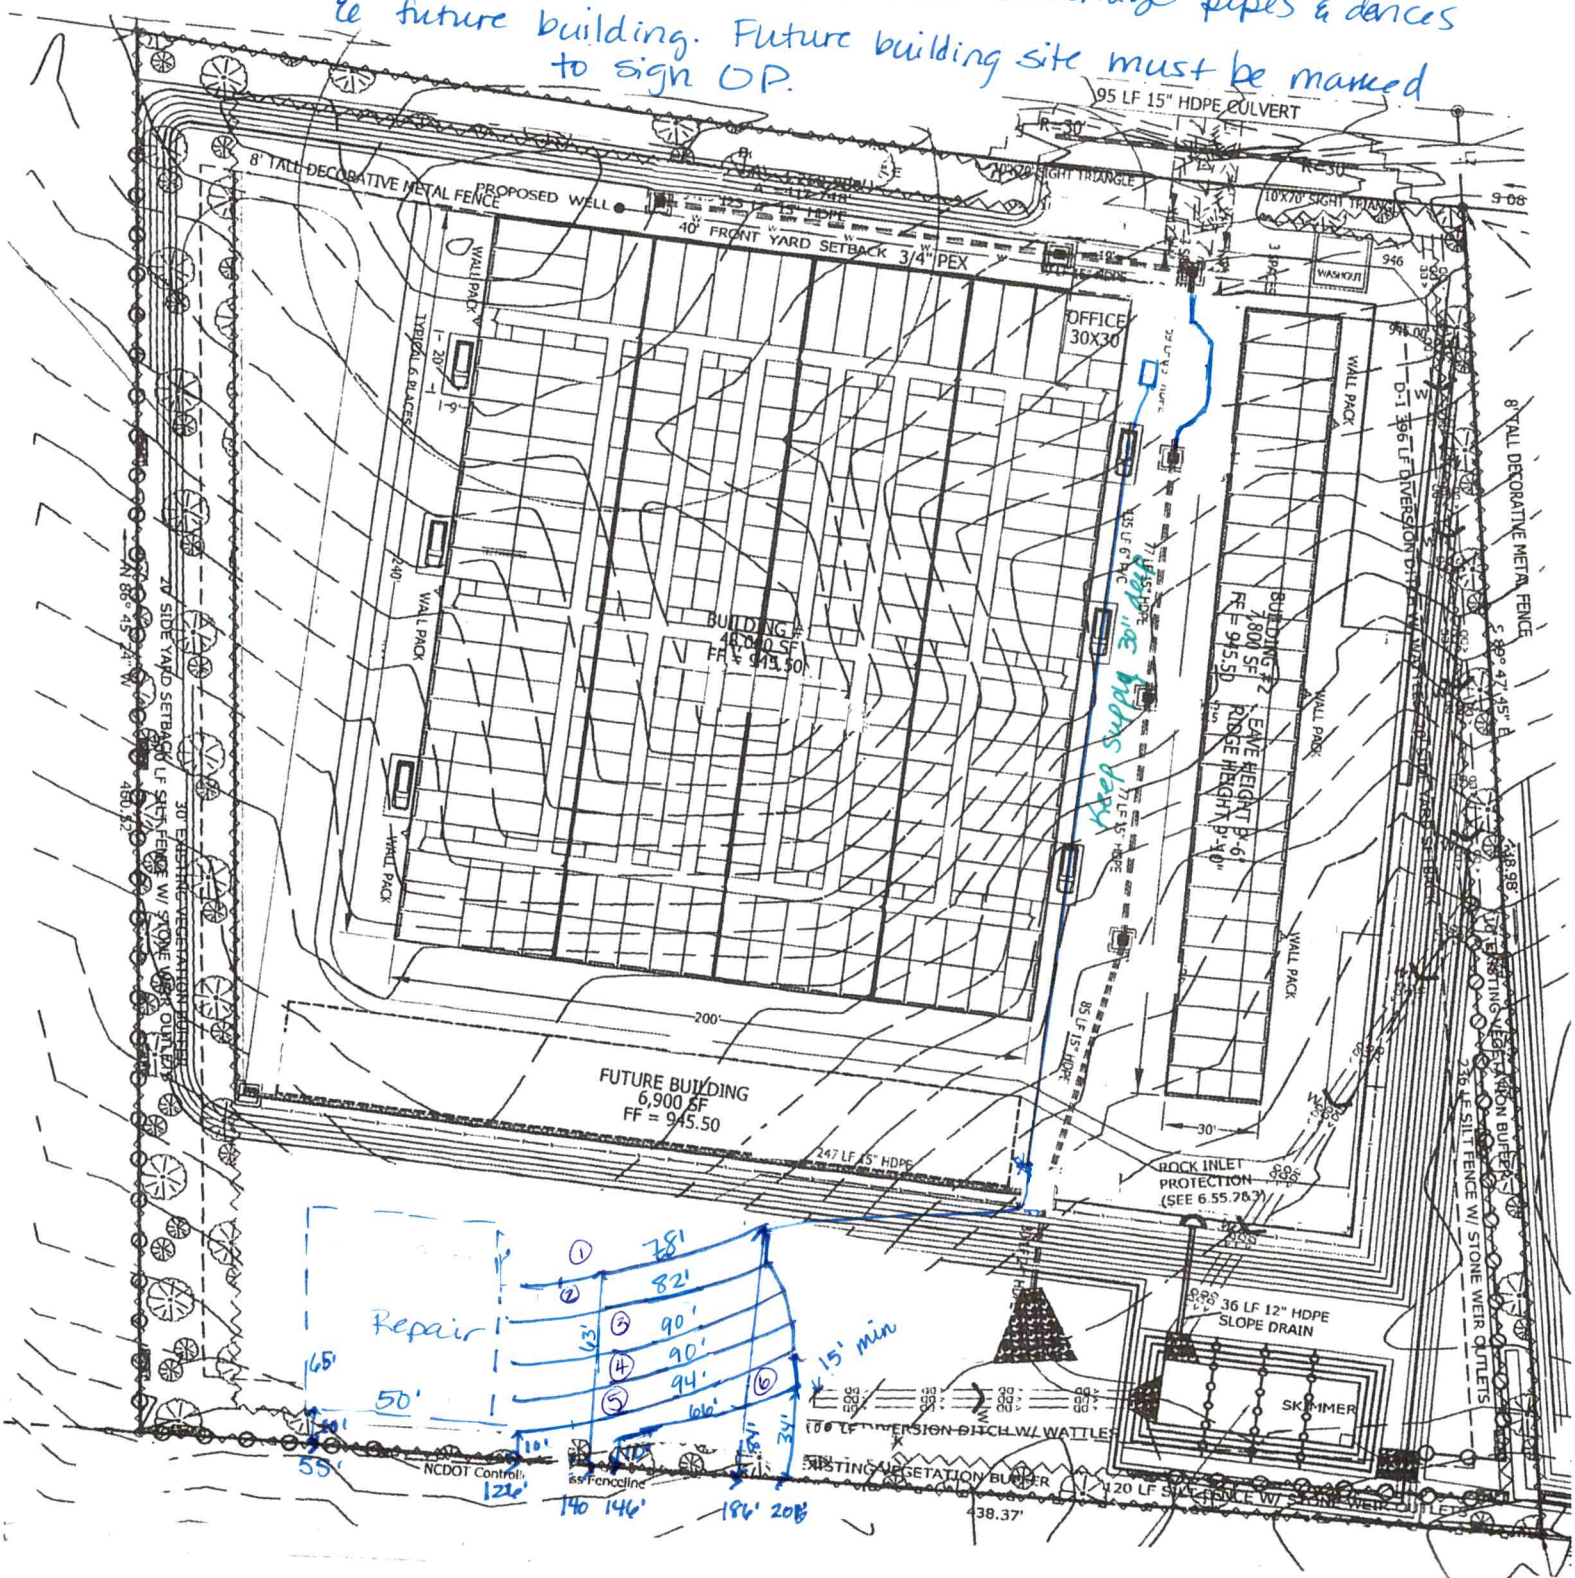


2 employees, 1 public restroom

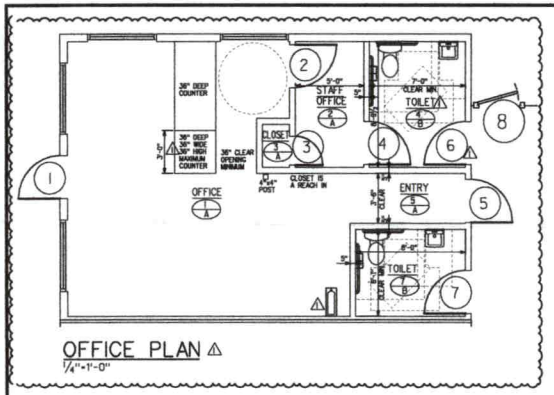


OFFICE PLAN ⚠
1/4"-1'-0"

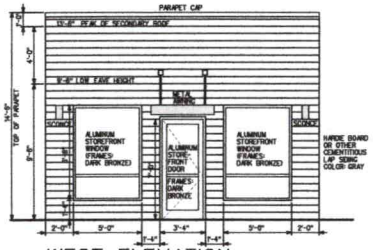


WEST ELEVATION
1/4"-1'-0"

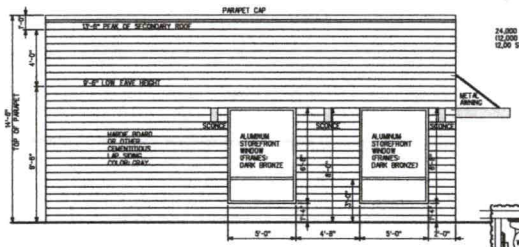


NORTH ELEVATION
1/4"-1'-0"

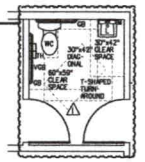


TOILET PLANS

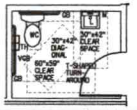

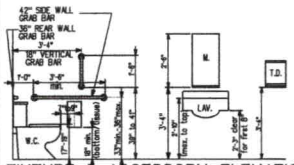

FIXTURE & ACCESSORY ELEVATIONS
3/8"-1'-0"

FIXTURE & ACCESSORY LEGEND			
G.B.	GRAB BAR	T.D.	TOWEL DISPENSER
L.	LAVATORY	T.H.	TISSUE HOLDER
M.	MIRROR	W.C.	WATER CLOSET
V.G.B.	VERTICAL GRAB BAR	W.R.	WASTE RECEPTACLE

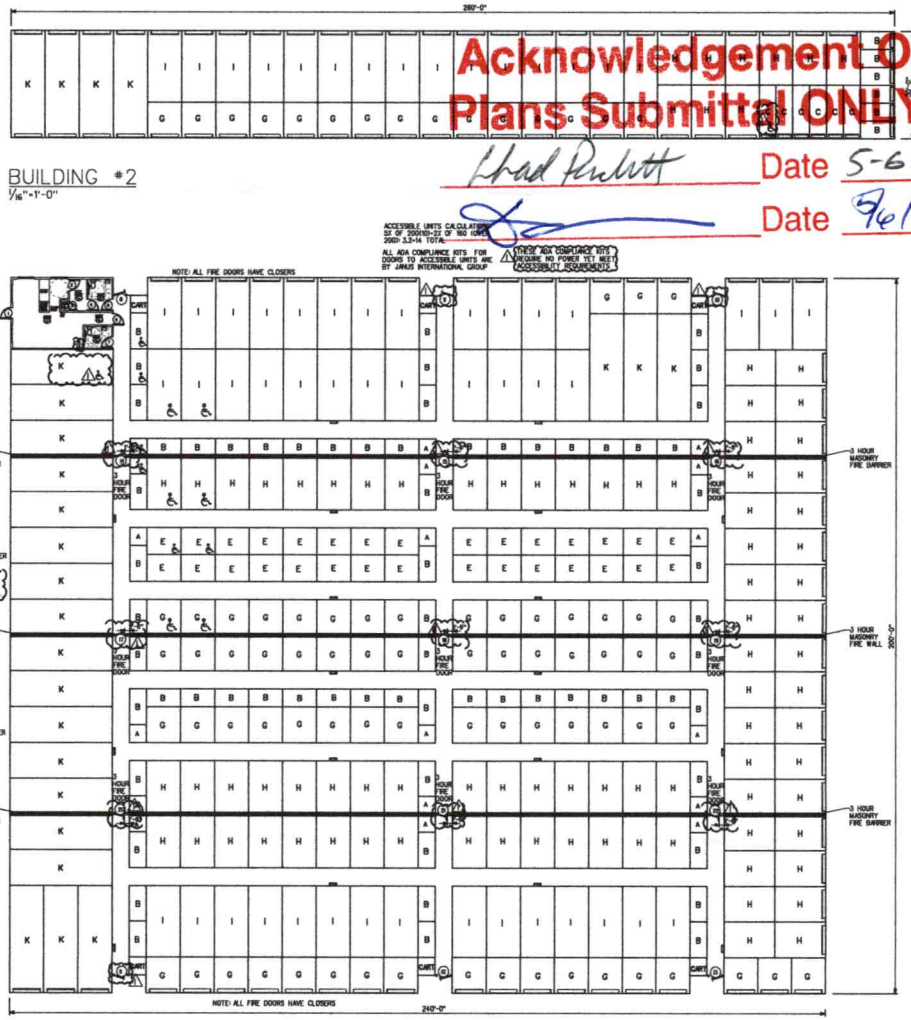

BUILDING #1
1/16"-1'-0"

BUILDING #2
1/16"-1'-0"

ACCESSIBLE UNITS CALCULATED AS 5% OF 200(100-2)= 5 OF 100 USED 200(1.3.1-14 TOTAL

ALL ADA COMPLIANCE KITS FOR DOORS TO ACCESSIBLE UNITS ARE BY JANUS INTERNATIONAL GROUP

SOME ADA COMPLIANCE KITS REQUIRE NO POWER YET MEET ACCESSIBILITY REQUIRMENTS

Acknowledgement Of Plans Submittal ONLY!

Chad Pickett Date 5-6-22

Date 5/6/22

N (BUILDING NORTH (BOTH BUILDINGS)) W E S


FINISH SCHEDULE							
FINISH SYMBOL	FLOOR	BASE	WALL MATERIAL	WALL FINISH	CEILING MATERIAL	CEILING FINISH	REMARKS
A	STAINED CONCRETE	VINYL	G.W.B.	PAINT	ACOUS.T.	---	
B	STAINED CONCRETE	VINYL	M.R.G.W.B.	PAINT ⚠	ACOUS.T.	---	⚠M.R.G.W.B. W/MOIS-ARRESTANT PAINT IN BATHROOM

FINISH SCHEDULE NOTES

INTERIOR FINISHES SHALL MEET THE REQUIREMENTS OF 803.9 NCSBC. INTERIOR WALL AND CEILING FINISHES IN EXIT ACCESS & CORRIDORS SHALL BE CLASSIFIED IN ACCORDANCE WITH ASTM E 84 AS CLASS B FINISHES WITH FLAME SPREAD 26-75 & SMOKE DEVELOPED 0-450. ALL OTHER INTERIOR FINISHES SHALL BE MIN. CLASS C FINISHES WITH FLAME SPREAD 76-200 & SMOKE DEVELOPED 0-450.

DOOR SCHEDULE					
DOOR NUMBER	DOOR TYPE	FRAME TYPE	LABEL	REMARKS	
1	A	ALUM		ALUMINUM STOREFRONT	
⚠ 2	B	HM		•3'-0" WIDE DOOR, DEAD BOLT LOCK ON START, DEADLOCK LOCK ON STRIKE SIDE	
3	B	HM		•2'-0" WIDE DOOR	
⚠ 4	B	HM		•3'-0" WIDE DOOR, DEAD BOLT LOCKS ON TOILET SIDE AND SLANT SIDE NO CLOSER ON THIS DOOR. DEAD BOLT LOCK ON OFFICE SIDE	
⚠ 5	C	HM		•3'-0" WIDE DOOR, DEAD BOLT LOCK ON TOILET SIDE	
6	C	HM		•3'-0" WIDE DOOR, DEAD BOLT LOCK ON TOILET SIDE	
7	C	HM		•3'-0" WIDE DOOR, DEAD BOLT LOCK ON TOILET SIDE	
⚠ 8,9,10,11,12,13	C	HM		EXTERIOR DOORS	
⚠ 14,15,16,17 ⚠ 18,19,20,21,22	B	HM	A	3 HOUR FIRE RATED DOORS	

1. CONTRACTOR TO PROVIDE ALLOWANCE FOR DOOR HARDWARE.
2. ALL HARDWARE TO CONFORM TO APPLICABLE CODES EGRESS HARDWARE TO CONFORM TO SECTION 1010.1.9 OF NCSBC.
3. ALL LATCHSETS & LOCKSETS TO BE LEVER HANDLE TYPE CONFORMING TO SECTION 404.2.6 (3" INCLUSIVE)

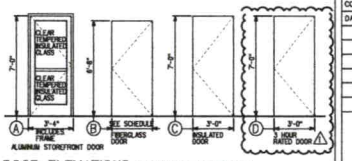

ALUMINUM STOREFRONT DOOR — INSULATED DOOR — 3 HOUR RATED DOOR ⚠

DOOR ELEVATIONS
SCALE: 1/4" = 1'-0"

NOTE: ALL HARDWARE THROUGHOUT TO BE IN COMPLIANCE WITH ACCESSIBILITY REQUIREMENTS

Wilbur Associates
Architecture / Planning
P.O. Box 438 - 20044 N. Elm St.
Cornelius, N.C. 28031
704-892-9633

NOTE
This drawing is property of the firm, Wilbur Associates. Reproduction or reuse in part or in whole without written permission is forbidden.

SEAL
STEPHEN CHARLES WILBUR II
REGISTERED ARCHITECT
4911
NORTH CAROLINA
4/8/22

TITLE

TWO NEW STORAGE BUILDINGS FOR
Storage Solutions by Lake Norman
321 FLOWER HOUSE LOOP
IREDELL COUNTY, NC

COMM. NO. 22-06
DATE 2/18/22
REVISIONS
⚠ 4/8/22

SHEET
A-1
OF -

Will this work? Move the piping for the storm drains 15' from the tank location, keep tank 5' from foundation. (see changes in red.)

321 Flower House Loop
Trautman, NC 28166



DEPARTMENT OF HEALTH AND HUMAN SERVICES
DIVISION OF PUBLIC HEALTH, ENVIRONMENTAL HEALTH SECTION
ON-SITE WATER PROTECTION BRANCH

Sheet 1 of 1
PROPERTY ID #: 7607722433
COUNTY: Iredell

1 public bathroom

SOIL/SITE EVALUATION
***for* ON-SITE WASTEWATER SYSTEM**
(Complete all fields in full)

OWNER: Puckett Property LLC
ADDRESS: 8257 Paytons Pt Denver 28037
PROPOSED FACILITY: Storage Units
LOCATION OF SITE: 321 Flower House Loop Troutman 28166
WATER SUPPLY: ☐ Private ☐ Public ☒ Well ☐ Spring ☐ Other
EVALUATION METHOD: ☐ Auger Boring ☒ Pit ☐ Cut

APPLICATION DATE: 3/31/22
DATE EVALUATED: 4/25/22
PROPOSED DESIGN FLOW (.1949): 300 gpd
PROPERTY SIZE: 4.62 ac
PROPERTY RECORDED: Yes
TYPE OF WASTEWATER: ☒ Sewage ☐ Industrial Process ☐ Mixed


PROFILE #	.1940 LANDSCAPE POSITION/ SLOPE %	HORIZON DEPTH (IN.)	SOIL MORPHOLOGY (.1941) .1941 STRUCTURE/ TEXTURE	SOIL MORPHOLOGY (.1941) .1941 CONSISTENCE/ MINERALOGY	OTHER PROFILE FACTORS .1942 SOIL WETNESS/ COLOR	OTHER PROFILE FACTORS .1943 SOIL DEPTH	OTHER PROFILE FACTORS .1956 SAPRO CLASS	OTHER PROFILE FACTORS .1944 RESTR HORIZ	PROFILE CLASS & LTAR
1	12%	0-29	C - SBK	SSSP-FR SEKP	slightly tight sap/Litho incl 29"+	54"	N/A 0-29" common	N/A	PS 0.3
		29-48	C/CL - SBK	↓					
		48-54	CL - WSBK	↓					
2	8%	0-38	C - SBK/ABK	SSSP-FR-SEKP VF1	very tight, slightly firm	56" few RR, mostly litho incl	N/A	N/A	PS 0.275
		38-56	CL - SBK	"					
3	5%	0-25	C SBK/ABK	SSSP-FR-SEKP	tight, common	52" litho incl 25"+ & mica	N/A	N/A	PS 0.275
		25-52	CL - SBK	"					
4	8%	0-16	C - SBK	SSSP-FR-SEKP	common sap	50"	N/A 16"+	N/A	PS 0.3
		16-38	CL - SBK	↓					
		38-50	L - WSBK	↓					

DESCRIPTION	INITIAL SYSTEM	REPAIR SYSTEM
Available Space (.1945)	273'	273'
System Type(s)	25% red	25% red
Site LTAR	0.275	

OTHER FACTORS (.1946):
SITE CLASSIFICATION (.1948): PS
EVALUATED BY: D Wieberg
OTHER(S) PRESENT:

COMMENTS:

Updated February 2014

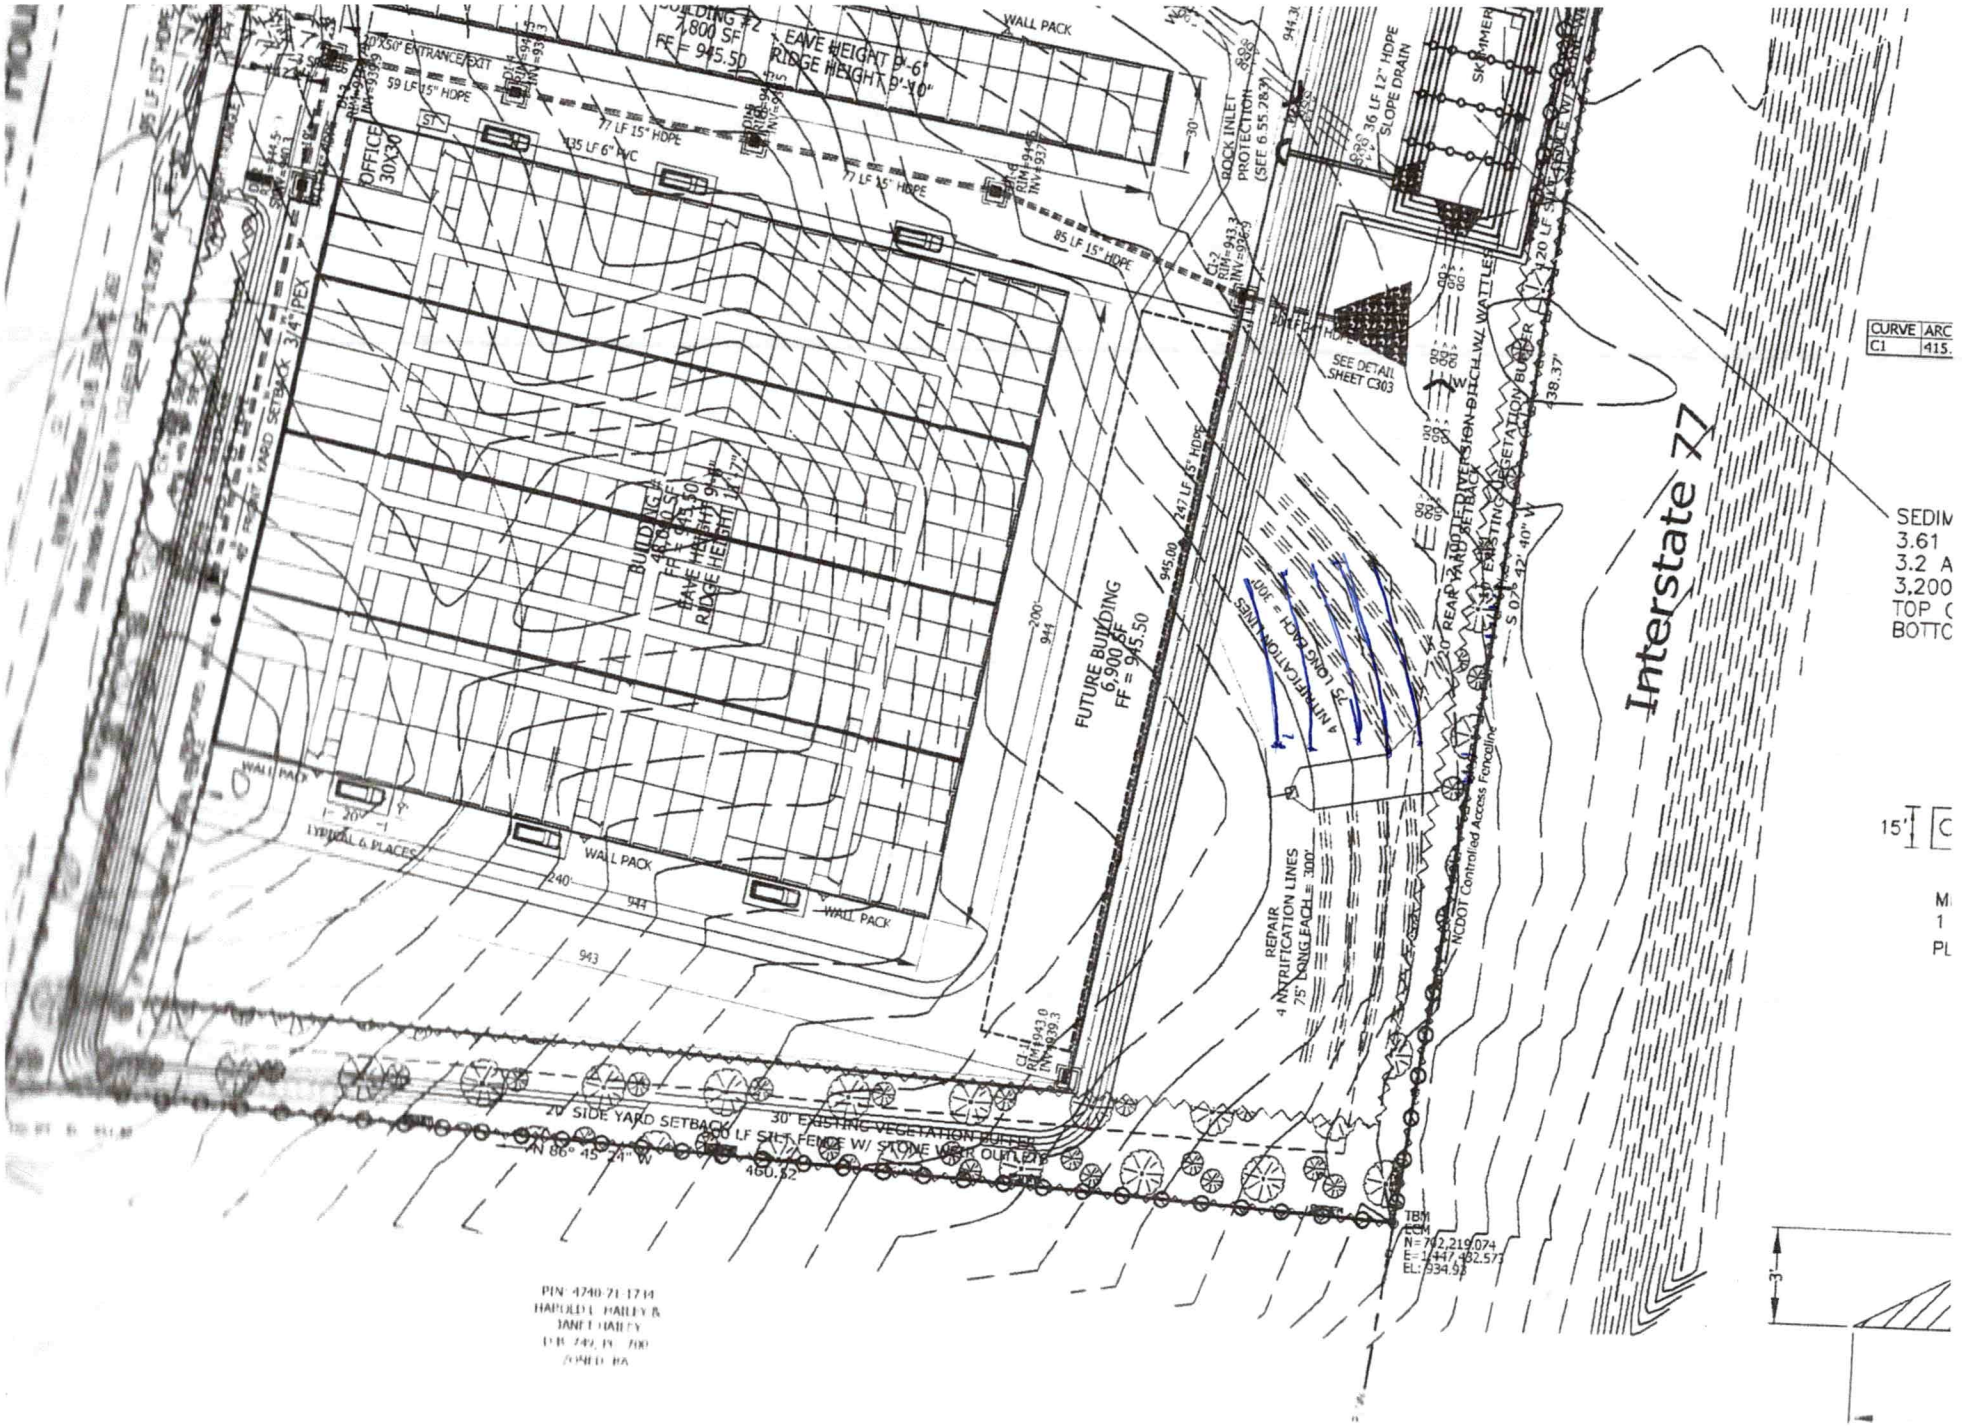
BUILDING #2
7,800 SF
FF = 945.50
EAVE HEIGHT 9'-6"
RIDGE HEIGHT 9'-10"
WALL PACK
20'X50' ENTRANCE/EXIT
59 LF 15" HDPE
77 LF 15" HDPE
135 LF 6" PVC
85 LF 15" HDPE
OFFICE 30X30
ROCK INLET PROTECTION (SEE 6.55.28)
36 LF 12" HDPE SLOPE DRAIN
SKIMMER
SEE DETAIL SHEET C303
247 LF 15" HDPE
FUTURE BUILDING
6,900 SF
FF = 945.50
BUILDING #1
4,800 SF
FF = 943.50
EAVE HEIGHT 9'-9"
RIDGE HEIGHT 14'-7"
3/4" IPEX
SIDE YARD SETBACK
REAR YARD SETBACK
30' EXISTING VEGETATION BUFFER
NCDOT Controlled Access Fencing
Interstate 77
4 NITRIFICATION LINES
75' LONG EACH = 300'
REPAIR
4 NITRIFICATION LINES
75' LONG EACH = 300'
20' SIDE YARD SETBACK
30' EXISTING VEGETATION BUFFER
200 LF SILT FENCE W/ STONE WEIR OUTLET
N 86° 45' 24" W
460.52
TBM
CM
N=702,219.074
E=1447,482.573
EL=934.93
PIN: 4740-71-1714
HAROLD L. BAILEY &
JANET BAILEY
DB 742, PG 700
ZONED: RA
CURVE
C1
SEDIM
3.61
3.2 A
3,200
TOP
BOTTO

RECEIVED MAR 3 1 2022

APPLICATION MUST BE FILLED OUT COMPLETELY & BE LEGIBLE
OR IT WILL NOT BE PROCESSED

AP- 325553

Iredell County Health Department – Environmental Health Division

PAGE 1: *APPLICATION FORM* Paid $500.00

Application For: (✓) New Well Permit ( ) Well Repair Permit ( ) Well Abandonment
(✓) Septic Improvement Permit ( ) Authorization to Construct ( ) Existing System Inspection ( ) Septic System Repair

THE ABOVE PERMIT DOCUMENTS WILL BECOME INVALID IF INFORMATION PROVIDED ON THIS APPLICATION IS FALSIFIED OR CHANGED, OR IF THE SITE IS ALTERED. THE IMPROVEMENT PERMIT IS VALID FOR EITHER 60 MONTHS OR WITHOUT EXPIRATION DEPENDING UPON DOCUMENTATION SUBMITTED. APPLICATION WITH SITE PLAN 60 MONTHS, APPLICATION WITH COMPLETE, SCALED PLAT WITHOUT EXPIRATION. SEE 15A NCAC 18A .1937(f) FOR DETAILS.

Page 2: *Site Plan Worksheet* form MUST accompany this application

The following optional attachments may also be submitted: ( ) Survey Plat, scaled no more than 1 inch = 60 feet
Place an (X) beside whichever is submitted if applicable (✓) Custom Site Plan, scaled no more than 1 inch = 60 feet

Applicant Information: (PRINT CLEARLY)

Applicant Name: R. Chad Puckett **Address:** 8257 Paytons Pointe Ln, Denver, NC 28037 **Zip:** 28037

Applicant Email: cpuckettconstruction@ymail.com **Phone:** 704-560-3517 **Alt. Phone:**

Owner Name: Puckett Property, LLC **Address:** 8257 Paytons Pointe Ln, Denver, NC 28037 **Zip:** 28037

Owner Email: cpuckettconstruction@ymail.com **Phone:** 704-560-3517 **Alt. Phone:**

Property Information:

Street Address: 321 Flower House Loop, Troutman, NC 28166

Subdivision Name: **Section/Phase:** **Lot Number:**

Driving Directions: From the intersection of Flower House Loop, SR 1312, and Clontz Hill Road, SR 1314, proceed south 600 feet, the subject property will be on the left.

Site Development Information: *(check or complete ALL that apply*

CHECK FOUNDATION TYPE

( ) New Single Family Residence
( ) New Multi-Family Residence
( ) Accessory Building
( ) Bedroom(s) Addition
( ) Repair to failing septic system ___ Tank ___ Drain lines **Describe Problem:**

Maximum Number of Bedrooms:
Maximum Number of Occupants:
( ) Swimming Pool
( ) Other Addition/Structure:

( ) Crawl Space Foundation
(✓) Concrete Slab Foundation
( ) Basement with Plumbing
( ) Basement without Plumbing

Non-Residential Site Development: **Type of Business:** Self storage facility
Square Footage of Building: 55,800 **Max. Number of Employees:** 2 **Max. Number of Seats/Beds/Other:** N/A

Water Supply:

( ) Replacement Well – Reason:
( ) Multi-connection Well **Number of Houses:** **Number of Persons:**

(✓) New Well ( ) Existing Well ( ) Community Well ( ) City Water ( ) Other Public Water

Desired Septic System Type: *(you may rank in order of preference)*

Year existing system installed:

( ) No Preference ( ) Alternative (✓) Conventional ( ) Innovative ( ) Modified Conventional ( ) Other:

Please answer the following to the best of your ability:

( ) Yes (✓) No Does the site contain any jurisdictional wetlands?
( ) Yes (✓) No Is any non-domestic sewage (i.e. industrial) to be generated?
(✓) Yes ( ) No Is the site subject to approval by any other public agency?

I have read this application and certify that the information provided herein is true, complete, and correct. Authorized county and state officials are granted right of entry to conduct necessary inspections to determine compliance with applicable laws and rules. I understand that I am solely responsible for the proper identification and labeling of all property lines and corners and making the site accessible so that a complete site evaluation can be performed.

Signature: R. Chad Puckett
Property owner or owner's legal representative signature (SIGNATURE REQUIRED)


March 31, 2022
DATE

IREDELL COUNTY HEALTH DEPARTMENT

ENVIRONMENTAL HEALTH DIVISION

PAGE 2: *SITE PLAN WORKSHEET*

SEE THE "SAMPLE SITE PLAN" BELOW. *INCOMPLETE SITE PLANS WILL BE RETURNED TO YOU FOR COMPLETION AND MAY RESULT IN A DELAY IN THE ISSUANCE OF YOUR SEPTIC SYSTEM PERMIT!!!*

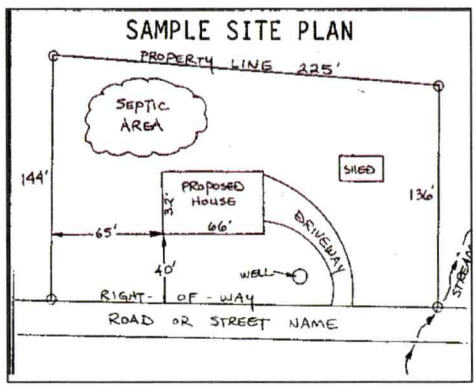

Place an (X) beside each item as you complete the site plan:

- (×) Property Line measurements are clearly identified
- (×) All proposed structures are indicated
- (×) Front and side setbacks from property line
- (×) Preferred driveway location and well location
- (×) Area you prefer your septic system to be placed
- (×) North arrow, or other sufficient indicator of direction

Circle N/A on the following if appropriate:

- Location of septic systems and wells within 100' of your property **N/A**
- Location of easements and rights of ways on your property **N/A**
- Location of any designated wetlands on the property **N/A**

USE THIS SPACE TO DRAW YOUR SITE PLAN

Show: proposed house or business footprint, wells, water lines, patios, pools and decks, and any other item that will occupy space on the site

SEE ATTACHED SITE PLAN

Full Set of Plans Submitted (Lg. plans)

Signature: R. Chad Puckett

Property owner or owner's legal representative signature (SIGNATURE REQUIRED)

March 31, 2022

DATE

Public Health
Prevent. Promote. Protect.
Iredell County Health Department

IREDELL COUNTY DEPARTMENT OF ENVIRONMENTAL HEALTH

Public Health
Prevent. Promote. Protect.
Iredell County Health Department

DOCUMENTATION TO AUTHORIZE AN OWNER'S LEGAL REPRESENTATIVE

(Check and sign only ONE of the options below)

☑ **1. * APPLICANT AND OWNER ARE THE SAME. *** (*Sign here*) R. Chad Puckett

Applications for permits require the "signature of the owner or owner's legal representative" (15A NCAC 18A .1937). If the owner does not sign the application himself or herself, they can submit any one of the following documents to designate their legal representative: *Power of Attorney; Real Estate Contract; Estate executor; Bankruptcy trustee; Court ordered guardianship*
In the absence of the above documentation, the property owner may provide the local health department with documentation that designates a legal representative. A property owner may:
Complete this form to document his or her legal representative, or provide his or her own form that contains the information in this form. If there are multiple property owners, then all property owners must sign the form that designates a legal representative.
By signing a form that designates a legal representative for purposes of 15A NCAC 18A .1937, the property owner authorizes that representative to act on their behalf in matters pertaining to the application and permitting process, including signing or receiving any application, document or permit. The owner retains full responsibility to meet all permit conditions specified by the local health department.

☑ **2.** I, R. Chad Puckett, am the legal owner(s) of the property located at Flower House Loop at Hawks Landing Drive, near Troutman, NC, identified as PIN (Parcel Identification Number) 4740-72-2433, located in Iredell County, North Carolina.

I do hereby authorize (**print legal representative/company name**) Gerald V. Grant, Jordan Grant & Associates, to act as an agent on my behalf in applying for/signing/obtaining any of the documents described below.

- Application for Improvement Permit (IP) / Authorization to Construct (AC)
- Improvement Permit (IP) / Authorization to Construct (AC)
- Application for soil-site evaluation (new/repair)
- Application/permit for private drinking water well/well abandonment
- Application for Compliance Inspection

I agree to abide by all decisions and/or conditions between the legal representative acting on my behalf and the Iredell County Department of Public Health, Environmental Health Division.

R. Chad Puckett
Signature of Owner(s)

03-31-2022
Date

Mooresville - Environmental Health

Fax: 704-662-3239
610 E. Center Avenue, Mooresville, NC 28115

Statesville - Environmental Health
ronda.hart@co.iredell.nc.us
Fax: 704-871-3483
349 N. Center Street, Statesville, NC 28677

ENVIRONMENTAL HEALTH REQUIREMENTS for SEPTIC and WELL PERMITS

The following items must be completed *PRIOR* to the *SUBMITTAL* of any Environmental Health Application. Incomplete applications will be returned to the applicant and cannot be processed or placed on the work list.

*** Initial all lines below to indicate you have submitted each form and completed every site requirement ****

GVG **Complete all Environmental Health forms**:

- GVG Application
- GVG Site Plan including the dimensions of proposed structure, addition, pool etc.
- GVG Documentation to Authorize Owner Agent (even if the property owner is the applicant – complete section 1 or 2)
- GVG Copy of Zoning Permit when applicable
- GVG Sign this sheet after you have completed all items

GVG **Lot must be cleared of heavy undergrowth**. In order to evaluate the lot, the footprint of the proposed structure must be visible. Adequate area for the septic drain field and repair area must be sufficiently cleared of heavy undergrowth, with 50 feet of visibility in all directions. Inspectors must be able to evaluate the property, shoot laser level elevations, layout the drain field, do soils work, etc. **If the lot is not cleared sufficiently, then a $100 site revisit fee will be charged and the evaluation will be put on HOLD until the requirement is met.**

GVG **Clearly mark all property corners by locating existing iron or concrete markers.** Flag all property lines every 25 feet if adjacent corners are not visible when standing on any given corner. Property lines must be flagged by a licensed NC surveyor & easily identified **prior to application submittal** (exception may apply for septic repair evaluations only). 'Mow lines' and/or fence lines do NOT constitute marked lines. **If the property lines are not properly marked when the lot is ready to be evaluated, then the application will be put on HOLD and a $100 site re-visit fee charged**.

GVG **Stake or flag the footprint of the proposed structure, addition, pool etc. to match the site plan submitted**. The proposed structure, etc. must be staked out on the property as per the site plan.

GVG **If an Authorization to Construct (AC) is desired,** submit a recorded copy of the plat for newly created or subdivided lot(s) and a LEGIBLE copy of the basic floor plan no larger than 8 ½" x 14" for each floor of the structure including decks, porches, etc. **The overall dimensions must be clearly noted & the rooms labeled.**

Any site not meeting the above requirements when staff arrives for the evaluation will result in a $100 site revisit fee being charged and the request being placed on HOLD. This will delay the processing of the application. *Once work by Environmental Health staff begins, the up-front fees paid toward securing any health department permit are nonrefundable. Refunds for work not started, due to a customer changing their mind or plans, are subject to an administrative fee of $50 to defray a portion of the costs of processing the refund.*

Backhoe pits are required for all applications that require a soils evaluation.
DO NOT DIG PITS UNTIL THE EH SPECIALIST HAS AUTHORIZED AND SCHEDULED YOUR EVALUATION TIME.

- **All utilities shall be marked before pits are dug. Call NC 811 for this service.**
- The applicant/agent is responsible for securing these services
- Backhoe pits are to be dug at the locations and depths determined by the Environmental Health Specialist or a NC Licensed Soil Scientist. A minimum of four pits must be dug.
- The EH specialist will contact you when your application is ready to be processed for pit scheduling.
- Your backhoe operator must be on site during the EH Specialist's evaluation to prevent your operator from having to return to the property for additional work.

By signing below, I am acknowledging the above specifications have been met and the site is READY to be evaluated AND I understand the backhoe pit requirement and will secure those services (if applicable).

Signature R. Chad Puckett **Date** 03-31-2022

Questions? Contact the Environmental Health Offices below:

Statesville Office
349 North Center Street (2nd Floor Building Standards)
Statesville, NC 28677-4063
Phone: (704)878-5305 ext. 3456

Mooresville Office
610 East Center Avenue (2nd Floor Govt. Center South)
Mooresville, NC 28115-2548
Phone: (704)660-3625