IREDELL COUNTY HEALTH DEPARTMENT

STATESVILLE 704-878-5305 MOORESVILLE 704-664-5281

IMPROVEMENT PERMIT / AUTHORIZATION TO CONSTRUCT / OPERATION PERMIT / EXISTING SYSTEM INSPECTION

4:00

PERMIT# 071608 PIN# 4740747832

OWNER OR CONTRACTOR MARK OVERCASH DATE 3/30/98

ADDRESS 207 FLOWER HOUSE LP TROUTMAN NC 28166 PHONE: Business _____ Home 528-9310

LOCATION # 207 FLOWER HOUSE LP

SUBDIVISION — BLOCK / SECTION — LOT — LOT AREA 7.0 AC SITE CLASS. RS DESIGN FLOW 300 ~ 1000 GPD L.T.A.R. .3

Septic Tank: 1400 Gallons; STB 794 Date 2/26/98

Pump Tank: _____ Gallons; PT _____ Date _____

Pump Make: _____ Model _____ Serial No. _____

Nitrification Field: No Fields 1 Square Feet 360 Linear Feet 120

No Lines 2@60' Trench Width 36" Max Trench Bottom Depth 36" Gravel Depth 12"

☑ New System ☐ Repair System Type: I, II, III, IV, V, VI

System Description: GRAVITY CONVENTIONAL

Repair System Description: SAME

Maintenance Agreement Required: ☐ Yes ☑ No

☐ House/Mod. Home No. Bedrooms ____

☐ Mobile Home No. Bathrooms ____

☑ Business No. Employees 2

☐ Other _____


☑ Slab ☐ Crawl Space ☐ Basement w/plumbing ☐ Basement wo/plumbing

Water Supply: ☑ Individual ☐ Public ☐ Community


Comments:/Conditions:

Comments:/Conditions:

INITIAL SITE SKETCH NO SCALE

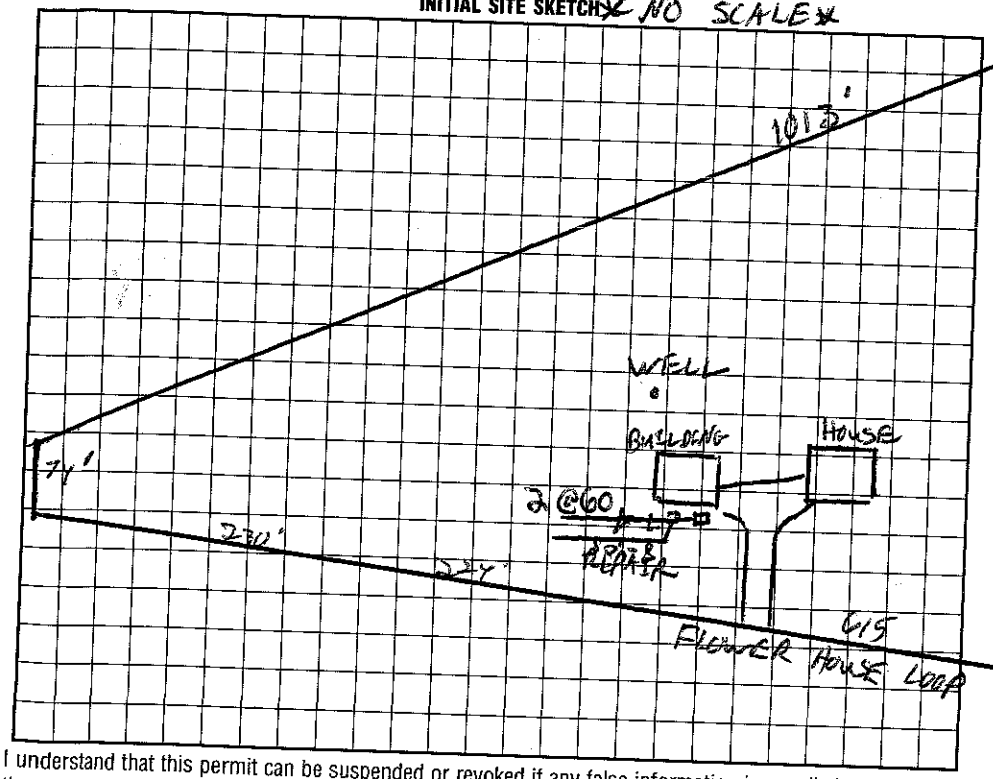

AS BUILT SKETCH

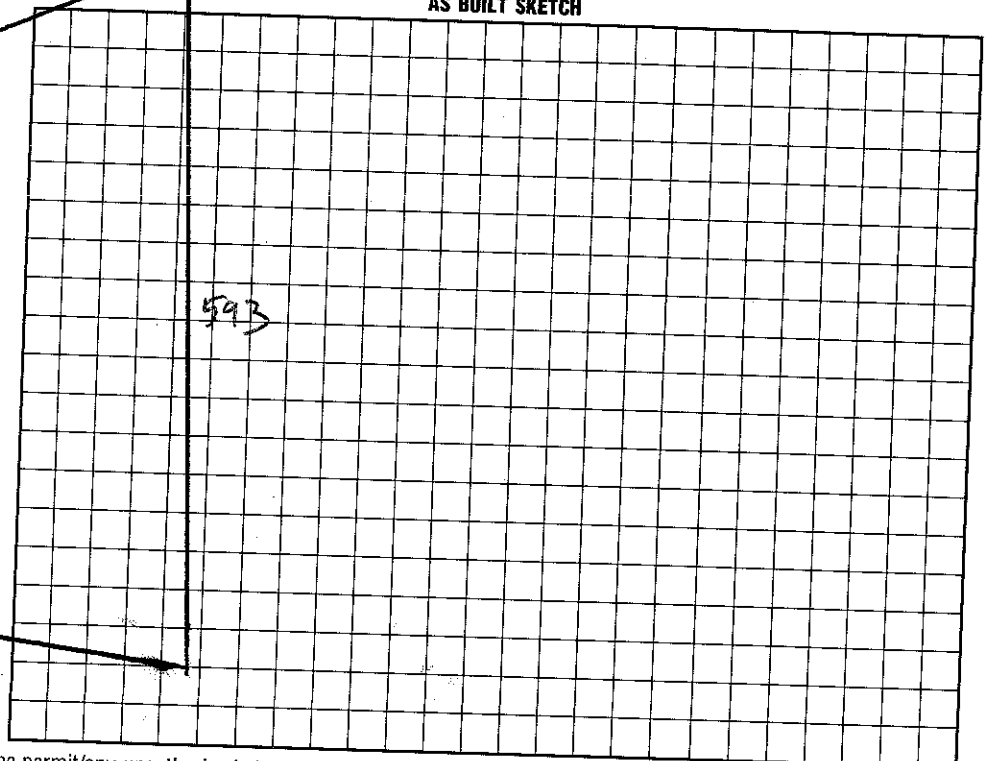

I understand that this permit can be suspended or revoked if any false information is supplied toward securing the permit/any unauthorized changes are made to the site/any unauthorized changes are made in the installation of the system. Improvement Permit with plat valid without expiration. Improvement Permit with site plan valid for sixty months. Authorization to Construct is valid for a period equal to that of Improvement Permit – not to exceed sixty months.

Signed: Mark R Overcash

Improvement Permit by: _____ date 5-29-98

Authorization to Construct by: _____ date 3/30/98

Installed by: McAlister Grading

Operation Permit by: Wesley Sparks RS date 6/4/98

Existing System Inspection by: Wesley Sparks RS date 6/4/98

HEALTH DEPT. COPY: WHITE INSPECTION COPY (FINAL): GREEN OWNER COPY (FINAL): YELLOW INSPECTION COPY (INITIAL): PINK OWNER COPY (INITIAL): GOLD