2.00

IREDELL COUNTY HEALTH DEPARTMENT

STATESVILLE 704-878-5305 MOORESVILLE 704-664-5281

IMPROVEMENT PERMIT / AUTHORIZATION TO CONSTRUCT / OPERATION PERMIT / EXISTING SYSTEM INSPECTION

PERMIT# 078412 PIN# ~~4740 80 2643 Pkg~~ 4740 80 2435 DATE 1/8/99

OWNER OR CONTRACTOR Sue Laughridge PHONE: Business Home 528-5844

ADDRESS PO Box 307 Trout Man, NC 28166

LOCATION 115 N TL 1st Flower House Loop ~ .7 mile on (R), first site on (L) past Dirked Well

SUBDIVISION BLOCK / SECTION LOT LOT AREA SITE CLASS. DESIGN FLOW L.T.A.R.

Septic Tank: 1000 Gallons; STB 1012 Date 11/25/98
Pump Tank: Gallons; PT Date
Pump Make: Model Serial No.
Nitrification Field: No Fields 1 Square Feet 1200 Linear Feet 400
No Lines 5 Trench Width 36" Max Trench Bottom Depth 36" Gravel Depth 12"

[X] New System [ ] Repair System Type: I, (II), III, IV, V, VI
System Description: Deputy - Conventional
Repair System Description:
Maintenance Agreement Required: [ ] Yes [X] No


[ ] House/Mod. Home No. Bedrooms 3
[X] Mobile Home No. Bathrooms 2
[ ] Business No. Employees
[ ] Other
[ ] Slab [X] Crawl Space [ ] Basement w/plumbing [ ] Basement wo/plumbing

Water Supply: [X] Individual [ ] Public [ ] Community


Comments:/Conditions:

Comments:/Conditions:

INITIAL SITE SKETCH

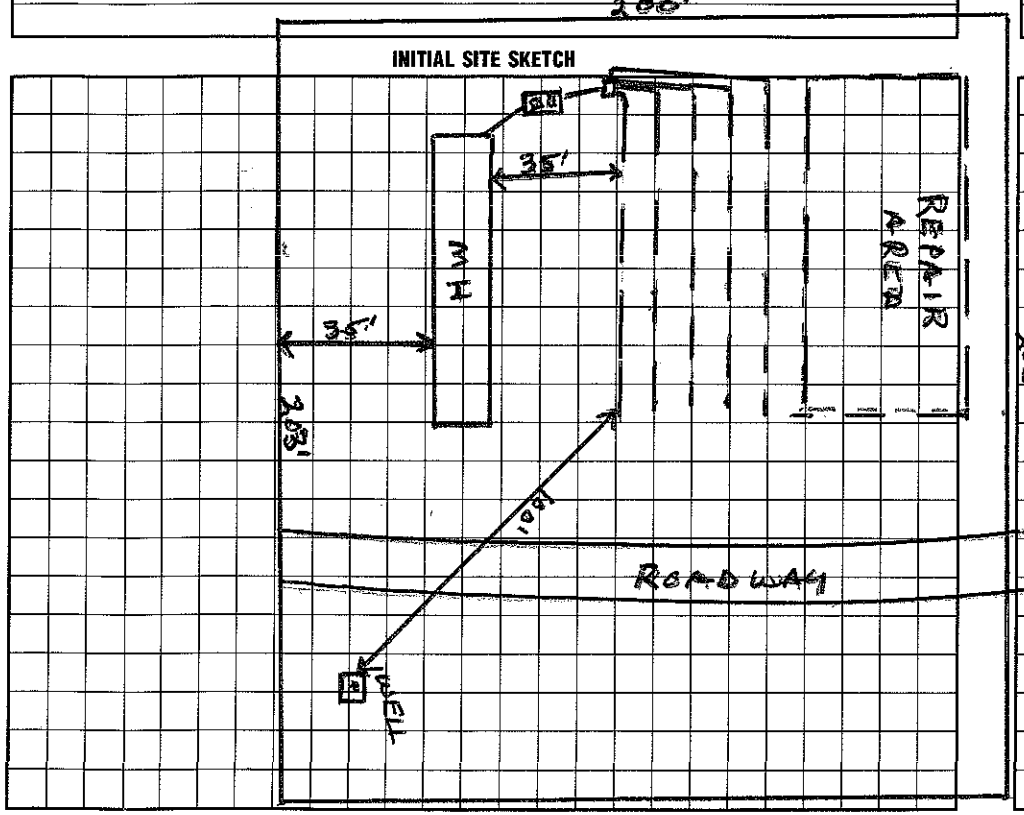

AS BUILT SKETCH

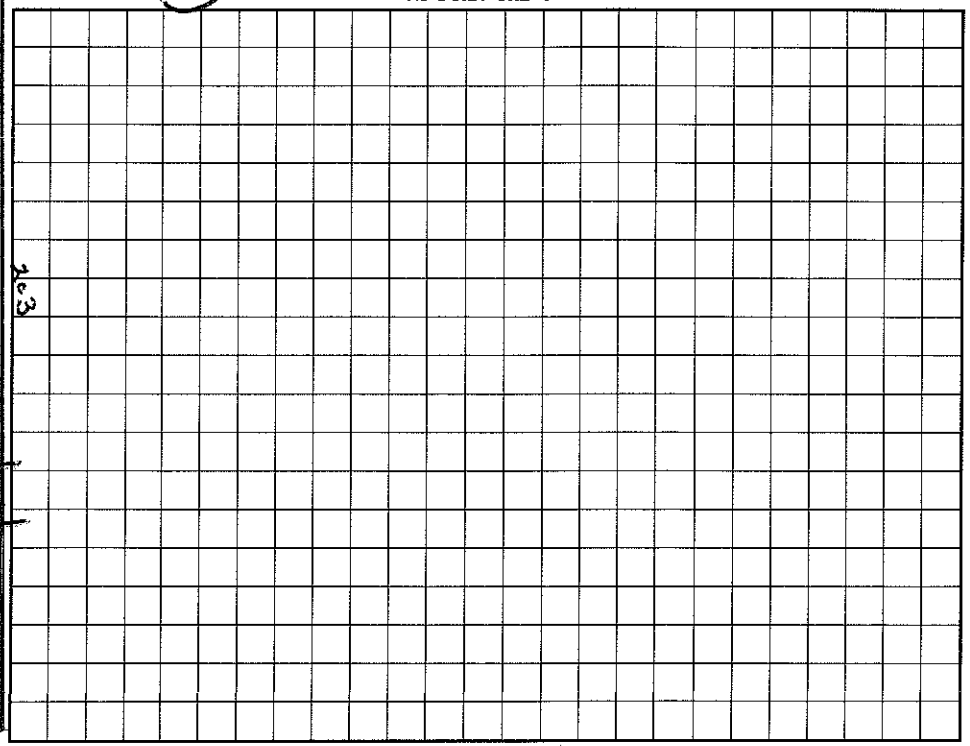

I understand that this permit can be suspended or revoked if any false information is supplied toward securing the permit/any unauthorized changes are made to the site/any unauthorized changes are made in the installation of the system. Improvement Permit with plat valid without expiration. Improvement Permit with site plan valid for sixty months. Authorization to Construct is valid for a period equal to that of Improvement Permit – not to exceed sixty months.

Signed: * Margaret Sue Laughridge date 1-15-99

Improvement Permit by: date

Authorization to Construct by: Wesley Sparks RS date 1/8/99

Installed by: FOREST SHAFFORD

Operation Permit by: C. [illegible] RS date 2/8/99

Existing System Inspection by: date

HEALTH DEPT. COPY: WHITE INSPECTION COPY (FINAL): GREEN OWNER COPY (FINAL): YELLOW INSPECTION COPY (INITIAL): PINK OWNER COPY (INITIAL): GOLD