IREDELL COUNTY HEALTH DEPARTMENT

STATESVILLE 704-878-5305 MOORESVILLE 704-664-5281

IMPROVEMENT PERMIT / AUTHORIZATION TO CONSTRUCT / OPERATION PERMIT / EXISTING SYSTEM INSPECTION

(10:30)

PERMIT# 073603 PIN# 4740 86 0101 DATE May 12, '98

OWNER OR CONTRACTOR Integrity Homes PHONE: Business Home

ADDRESS 894 S. Main / Trentman

LOCATION Hwy 115-21 N x under I-77 TL Flower House Loop 500-1000' on left

SUBDIVISION BLOCK / SECTION LOT LOT AREA 1.52A SITE CLASS. PS DESIGN FLOW 125gpd L.T.A.R. .03

Septic Tank: Existing Gallons; STB Date

Pump Tank: Gallons; PT Date

Pump Make: Model Serial No.

Nitrification Field: No Fields 1 Square Feet 450 Linear Feet 150

No Lines 3@50 Trench Width 36" Max Trench Bottom Depth 36"

☐ New System ☐ Repair System Type: I, II, III, IV, V, VI

System Description: Conventional Fill

Repair System Description: Same

Maintenance Agreement Required: ☐ Yes ☐ No

Gravel Depth 12"

☐ House/Mod. Home No. Bedrooms

☐ Mobile Home No. Bathrooms

☑ Business No. Employees 5

☐ Other


☐ Slab ☑ Crawl Space ☐ Basement w/plumbing ☐ Basement wo/plumbing

Water Supply: ☐ Individual ☐ Public ☐ Community


Comments/Conditions: Check existing tank for structural problems (cracks, etc) after pumping. Usable to locate existing drainfield probably due to depth.

Comments/Conditions: Attention Bld Inspection Dept - Please collect #125 additional fee for Septic Permit

INITIAL SITE SKETCH

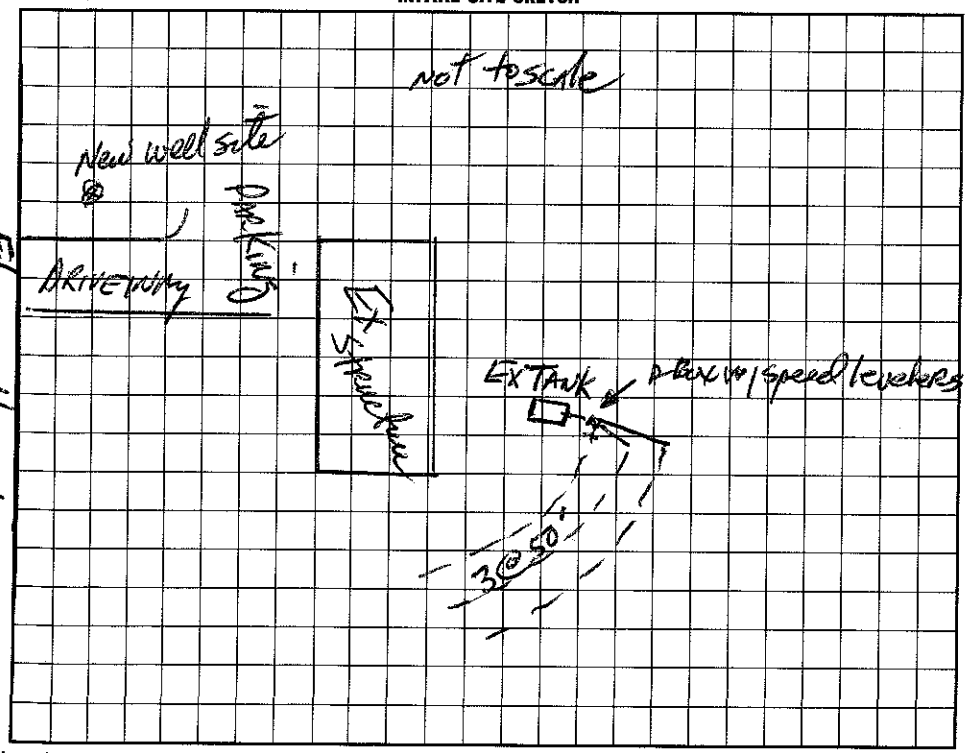

AS BUILT SKETCH

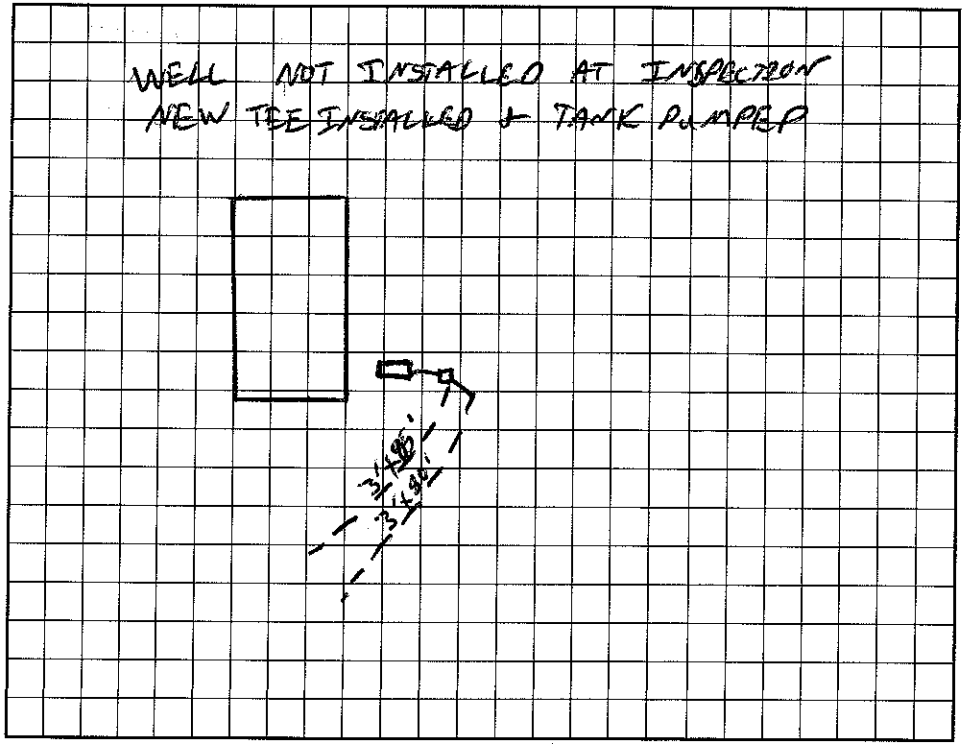

I understand that this permit can be suspended or revoked if any false information is supplied toward securing the permit/any unauthorized changes are made to the site/any unauthorized changes are made in the installation of the system. Improvement Permit with plat valid without expiration. Improvement Permit with site plan valid for sixty months. Authorization to Construct is valid for a period equal to that of Improvement Permit – not to exceed sixty months.

Signed: X date

Improvement Permit by: Mark Bathmon, RS date 5-12-98

Authorization to Construct by: date

Installed by: A1 BACKHOE

Operation Permit by: C. [illegible] Freeman date 6/2/98

Existing System Inspection by: date

HEALTH DEPT. COPY: WHITE INSPECTION COPY (FINAL): GREEN OWNER COPY (FINAL): YELLOW INSPECTION COPY (INITIAL): PINK OWNER COPY (INITIAL): GOLD