IREDELL COUNTY HEALTH DEPARTMENT

STATESVILLE 704-878-5305 MOORESVILLE 704-664-5281

10:00

IMPROVEMENT PERMIT / AUTHORIZATION TO CONSTRUCT / OPERATION PERMIT / EXISTING SYSTEM INSPECTION

PERMIT# 124451 PIN# 4740-88-2314 DATE 11/12/04

OWNER OR CONTRACTOR JM Cope Const. Co. Inc PHONE: Business 803-329-3250 Home

ADDRESS Po Box 4047 Rock Hill SC 29732

LOCATION HWY 21/115N, IR Oswalt Amity on Rt #144 144 Oswalt Amity

SUBDIVISION BLOCK / SECTION LOT LOT AREA 2.06 AC SITE CLASS. PS DESIGN FLOW 300 L.T.A.R. 0.3

Septic Tank: 1000 Gallons; STB 794 Date 2-21-04

Pump Tank: Gallons; PT Date

Pump Make: Model Serial No. 250

Nitrification Field: No Fields 1 Square Feet 990 Linear Feet ~~330~~

No Lines 30/40' Trench Width 36" Max Trench Bottom Depth 36" Gravel Depth 12"

☒ New System ☐ Repair System Type: I, II, III, IV, V, VI (II)

System Description: Gravity Conventional 25% Red

Repair System Description: Same

Maintenance Agreement Required: ☐ Yes ☒ No

☐ House/Mod. Home No. Bedrooms

☐ Mobile Home No. Bathrooms

☒ Business No. Employees ~~*~~

☐ Other

☒ Slab ☐ Crawl Space ☐ Basement w/plumbing ☐ Basement wo/plumbing

Water Supply: ☒ Individual ☐ Public ☐ Community

Comments:/Conditions:


NOT to Scale

Comments:/Conditions:


~~*~~ 10 Full Time onsite Employees @ 25gpd = 250

10 offsite Employees @ 5gpd = 50gpd

INITIAL SITE SKETCH

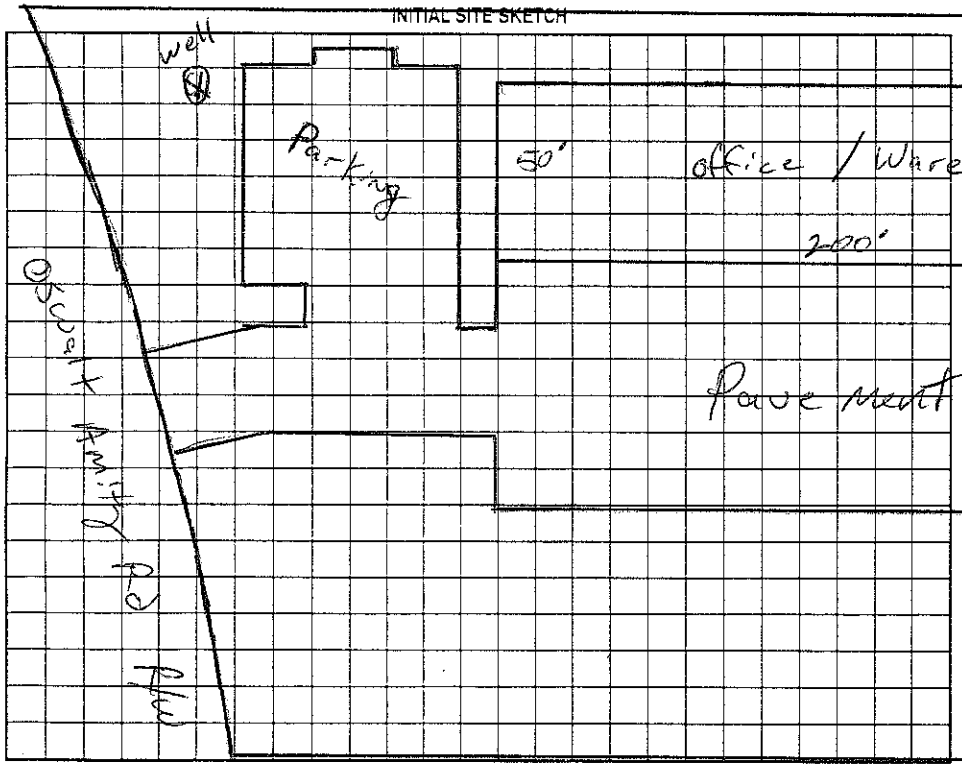

AS BUILT SKETCH

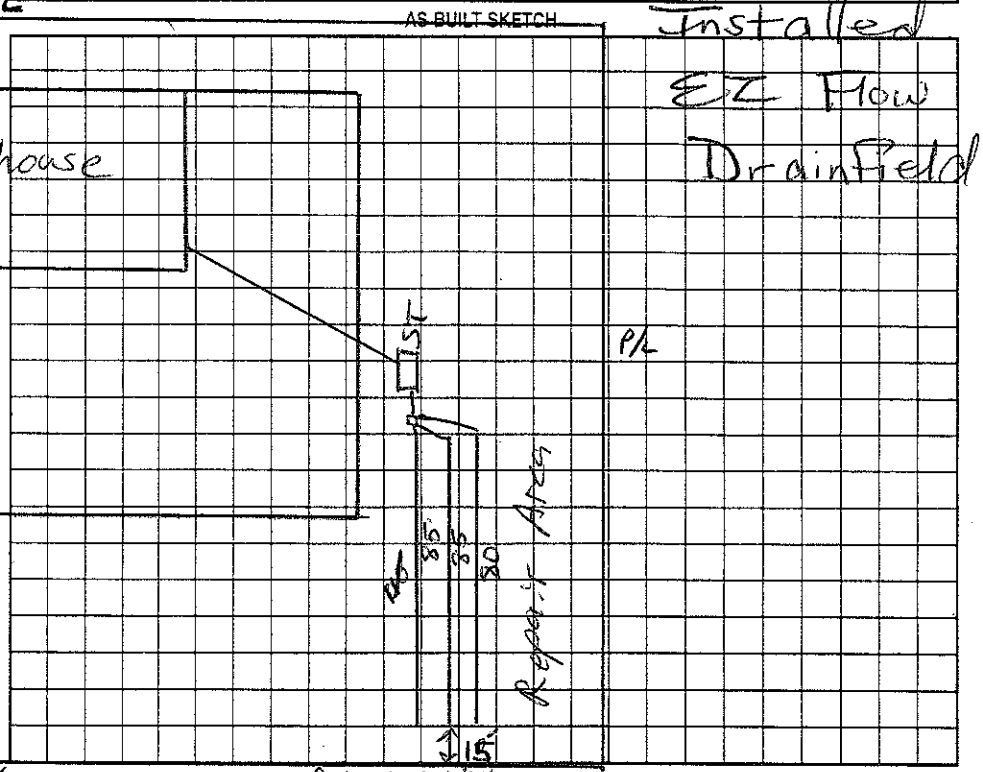

Permit can be suspended or revoked if any false information is supplied toward securing the permit/any unauthorized changes are made to the site/any unauthorized changes are made in the installation of the system. Improvement Permit with plat valid without expiration. Improvement Permit with site plan valid for sixty months. Authorization to Construct is valid for a period equal to that of Improvement Permit – not to exceed sixty months.

Signed: date 11/30/04 Installed by: R&H RS

Improvement Permit by: RS date 11/12/04 Operation Permit by: Maria Dotson RS date 4/28/05

Authorization to Construct by: RS date 11/12/04 Existing System Inspection by: date

HEALTH DEPT. COPY: WHITE OWNER COPY (FINAL): YELLOW OWNER COPY (INITIAL): PINK