IREDELL COUNTY HEALTH DEPARTMENT

STATESVILLE 704-878-5305 MOORESVILLE 704-664-5281

IMPROVEMENT PERMIT / AUTHORIZATION TO CONSTRUCT / OPERATION PERMIT / EXISTING SYSTEM INSPECTION

PERMIT# REDATE PIN# 4740-88-2759 DATE 5-2-04

OWNER OR CONTRACTOR JUNE STEVENSON PHONE: Business Home 704-902-4132 ANGELA ROGERS

ADDRESS 149 OSTWALT ANDY RD TROUTMAN NC 28166

LOCATION 21 SOUTH, L OSTWALT ANDY 3RD HOUSE ON LEFT @ BOX # 149

SUBDIVISION BLOCK / SECTION LOT LOT AREA SITE CLASS DESIGN FLOW 360 L.T.A.R. EXISTING

Septic Tank: 1000 Gallons; STB 794 Date 5-14-04

Pump Tank: Gallons; PT Date

Pump Make: Model Serial No.

Nitrification Field: No Fields 1 Square Feet 1700' Linear Feet 300'

No Lines 3X100' Trench Width 36" Max Trench Bottom Depth 36" Gravel Depth 24"

☒ New System ☒ Repair System Type: I, II, III, IV, V, VI

System Description: ~~CONVENTIONAL~~ INSTALLED 25% TO 100

Repair System Description: MAX FOOT

Maintenance Agreement Required: ☐ Yes ☐ No

☒ House/Mod. Home No. Bedrooms 3

☐ Mobile Home No. Bathrooms 2

☐ Business No. Employees

☐ Other


☐ Slab ☐ Crawl Space ☐ Basement w/plumbing ☐ Basement wo/plumbing

Water Supply: ☒ Individual ☐ Public ☐ Community


Comments/Conditions: ① PUMP / COLLAPSE / FILL OLD TANK ② INSTALL NEW SUPPLY MINIMUM 50' FROM WELL & NEW SEPTIC MINIMUM OF 50' DOWNSLOPE OF UNCASED WELL ③ MAINTAIN SETBACKS

Comments/Conditions: ① THIS PERMIT SERVES AS NOTICE OF UTILITATION & MUST BE REPAIRED WITHIN 28 DAYS. ZABEL FILTER & MARKER

INITIAL SITE SKETCH

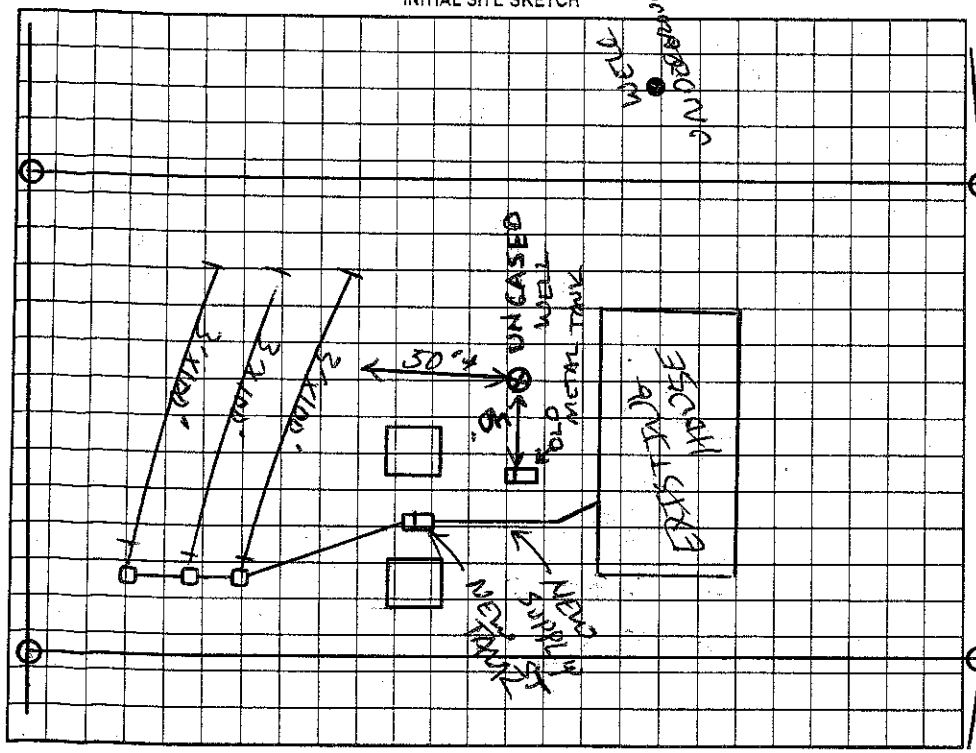

AS BUILT SKETCH

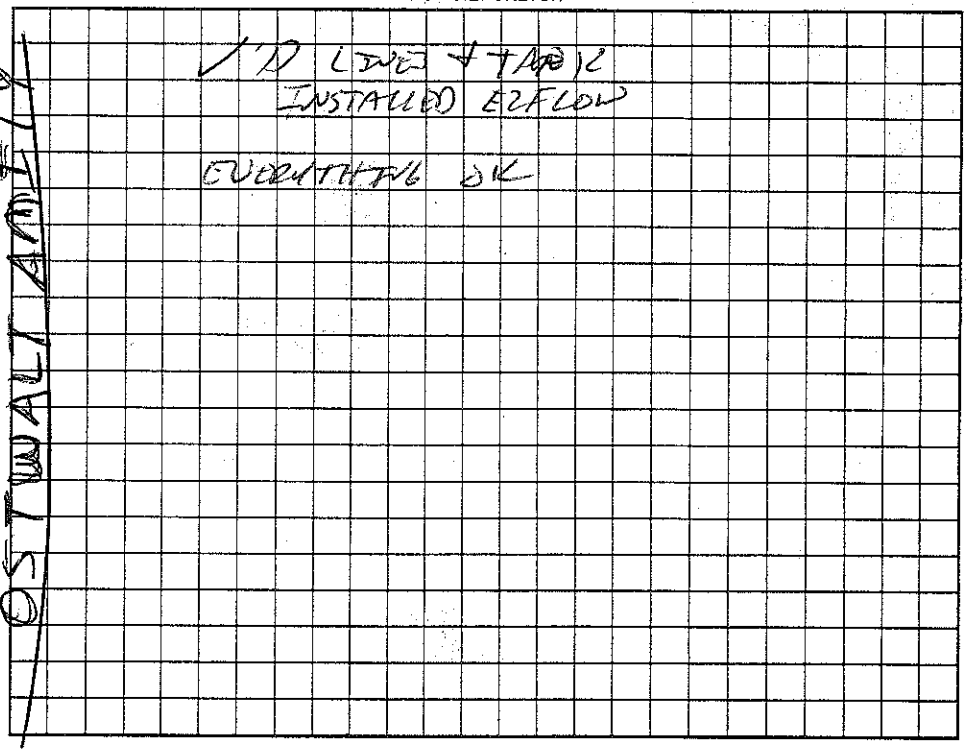

Permit can be suspended or revoked if any false information is supplied toward securing the permit/any unauthorized changes are made to the site/any unauthorized changes are made in the installation of the system. Improvement Permit with plat valid without expiration. Improvement Permit with site plan valid for sixty months. Authorization to Construct is valid for a period equal to that of Improvement Permit – not to exceed sixty months.

Signed: Angela Rogers date 5/3/04 Installed by: WES LYTTON

Improvement Permit by: date 5-2-04 Operation Permit by: date 7-8-04

Authorization to Construct by: date 5-2-04 Existing System Inspection by: date

HEALTH DEPT. COPY: WHITE OWNER COPY (FINAL): YELLOW OWNER COPY (INITIAL): PINK