IREDELL COUNTY HEALTH DEPARTMENT

STATESVILLE 704-878-5305 MOORESVILLE 704-664-5281

IMPROVEMENT PERMIT / CERTIFICATE OF COMPLETION / OPERATION PERMIT / EXISTING SYSTEM INSPECTION

PROPERTY DESCRIPTION NO. 072452 DATE 3/30/98 TAX MAP NO. 4740-88-4678 Watershed: ☐ Yes ☒ No

OWNER OR CONTRACTOR Danny Sherrill PHONE: Business _____ Home 662-8436

ADDRESS 158 Oswalt Smith Rd, Troutman, NC. 28166

LOCATION Oswalt Smith Rd on (R) before Church

SUBDIVISION N/A BLOCK / SECTION _____ LOT _____ LOT AREA .56Ac SITE CLASS. PS DESIGN FLOW 360 L.T.A.R. .3

Septic Tank: 1000 Gallons; STB 1009 Date 3/13/98

Pump Tank: _____ Gallons; PT _____ Date _____

Pump Make: _____ Model _____ Serial No. _____

Nitrification Field: No Fields 1 Square Feet 1200 Linear Feet 400

No Lines 3 Trench Width 36" Max Trench Bottom Depth _____ Gravel Depth _____

☒ New System ☐ Repair System Type: I, II, (III) IV, V, VI

System Description: GRAV - CONVENTIONAL

Repair System Description: _____

Maintenance Agreement Required: ☐ Yes ☒ No

☒ House/Mod. Home No. Bedrooms 3

☐ Mobile Home No. Bathrooms 2

☐ Business No. Employees _____

☐ Other _____


☐ Slab ☒ Crawl Space ☐ Basement w/plumbing ☐ Basement wo/plumbing

Water Supply: ☒ Individual ☐ Community ☐ Public


Comments:

Comments:

INITIAL SITE SKETCH

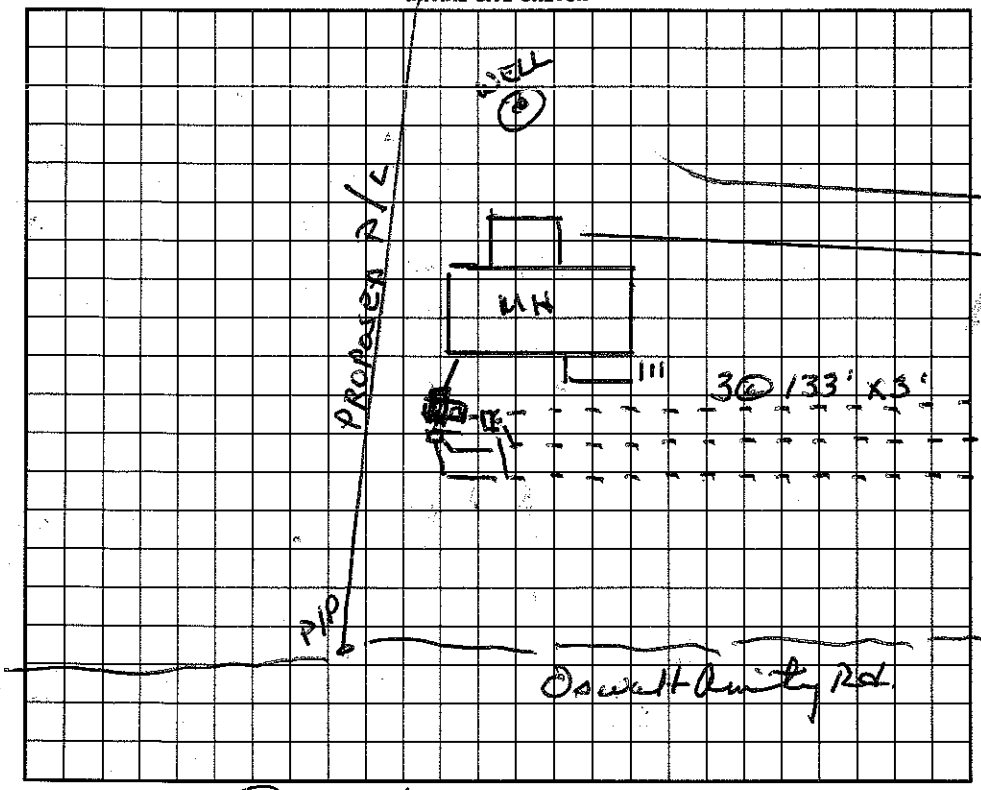

AS BUILT SKETCH

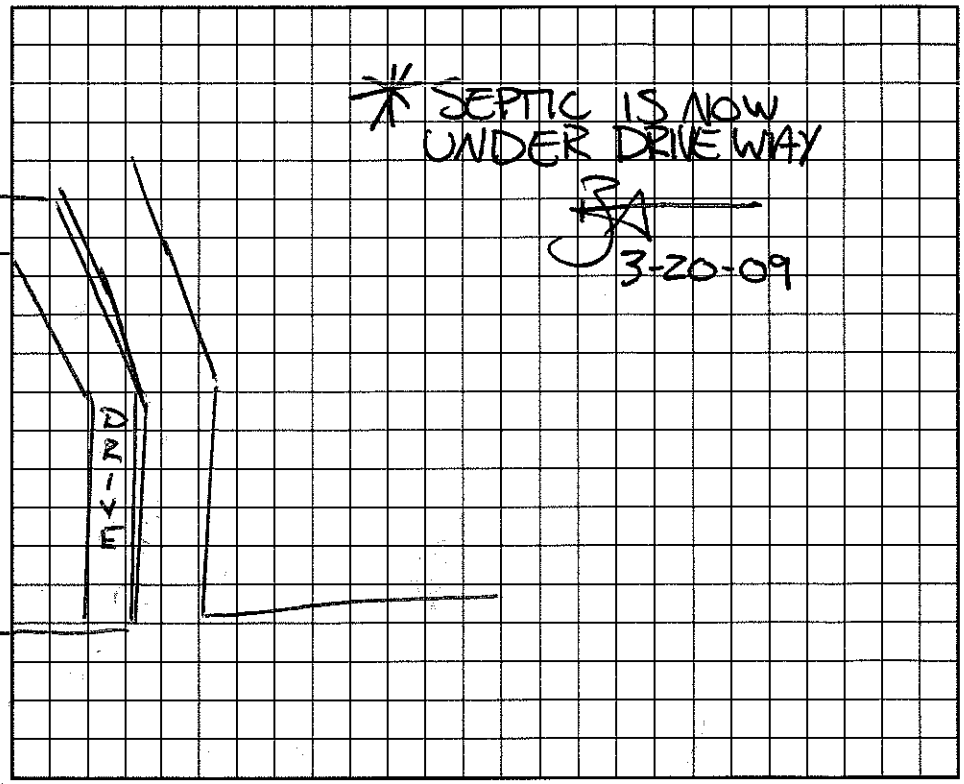

I understand that this permit can be suspended or revoked if any false information is supplied toward securing the permit/any unauthorized changes are made to the site/any unauthorized changes are made in the installation of the system. Improvement Permit is valid for 60 months from date of issuance.

Signed: X Danny Sherrill

Improvement Permit by: Wesley Sparks RS. date 3/30/98

Existing System Inspection by: Wesley Sparks RS. date 3/30/98

Installed by: James Hudson

Certificate of Completion by: Wesley Sparks RS date 4/24/98

Operation Permit by: Wesley Sparks RS date 4/24/98

HEALTH DEPT. COPY: WHITE INSPECTION COPY (FINAL): GREEN OWNER COPY (FINAL): YELLOW INSPECTION COPY (INITIAL): PINK OWNER COPY (INITIAL): GOLD