4740884670

IREDELL COUNTY HEALTH DEPARTMENT

STATESVILLE 704-878-5305 MOORESVILLE 704-664-5281

IMPROVEMENT PERMIT / CERTIFICATE OF COMPLETION / OPERATION PERMIT / EXISTING SYSTEM INSPECTION

PROPERTY DESCRIPTION NO. 22388 DATE Nov 17, '95 TAX MAP NO. part of 4743 Watershed: ☐ Yes ☑ No

OWNER OR CONTRACTOR Gary Sherrill PHONE: Business _____ Home _____

ADDRESS 444 Ridgedale Dr. Troutman

LOCATION 115-21 N to SR 1001 (Ostwalt Amity) - ½ mile on Right just before Church

SUBDIVISION _____ BLOCK / SECTION _____ LOT _____ LOT AREA 2.5Ac SITE CLASS: PS DESIGN FLOW 360gpd L.T.A.R. .3

Septic Tank: 1000 Gallons; STB 760 Date 11/27/96

Pump Tank: _____ Gallons; PT _____ Date _____

Pump Make: _____ Model _____ Serial No. _____

Nitrification Field: No Fields 1 Square Feet 1200 Linear Feet 400

No Lines 3@133' Trench Width 36" Max Trench Bottom Depth ≈ 30" Gravel Depth 12"

☑ New System ☐ Repair System Type: I, II, III, IV, V, VI

System Description: gravity conventional

Repair System Description: same

Maintenance Agreement Required: ☐ Yes ☑ No

☐ House/Mod. Home No. Bedrooms 3

☑ Mobile Home DW No. Bathrooms 2

☐ Business No. Employees _____

☐ Other _____


☐ Slab ☑ Crawl Space ☐ Basement w/plumbing ☐ Basement wo/plumbing

Water Supply: ☑ Individual ☐ Community ☐ Public

Comments: Old farm terraces to be removed.

Comments:

INITIAL SITE SKETCH

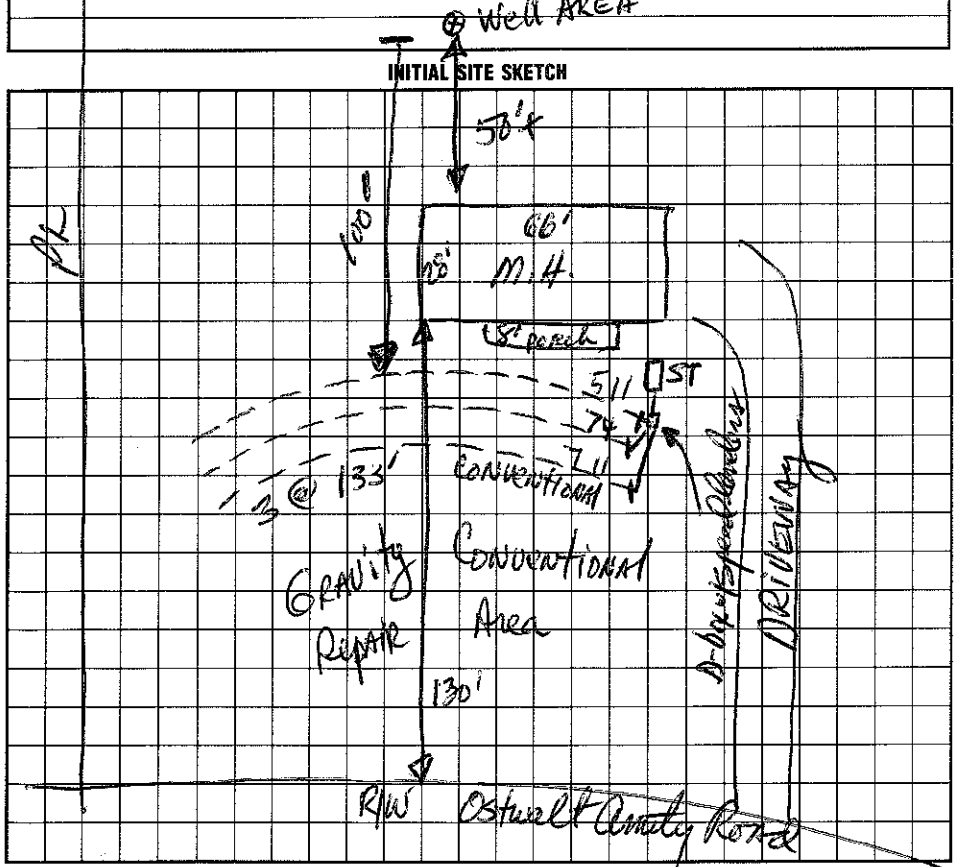

AS BUILT SKETCH

I understand that this permit can be suspended or revoked if any false information is supplied toward securing the permit/any unauthorized changes are made to the site/any unauthorized changes are made in the installation of the system.

Signed: Gary Sherrill

Improvement Permit by: Larry Patterson, RS date 11-17-95

Existing System Inspection by: Larry Patterson, RS date 11-17-95

Installed by: Grimes Septic Tanks

Certificate of Completion by: _____ date _____

Operation Permit by: C. Rudy Foerster EHSS date _____

TO CONTRACTOR COPY: WHITE INSPECTION COPY (FINAL): GREEN OWNER COPY (FINAL): YELLOW INSPECTION COPY (INITIAL): PINK OWNER COPY (INITIAL)