IREDELL COUNTY HEALTH DEPARTMENT

STATESVILLE 704-878-5305 MOORESVILLE 704-664-5281

IMPROVEMENT PERMIT / AUTHORIZATION TO CONSTRUCT / OPERATION PERMIT / EXISTING SYSTEM INSPECTION

PERMIT# 136717 PIN# ~~4740 88 8679~~ 4748 88 8740 DATE 7/24/06

OWNER OR APPLICANT Palm Harbor Homes Inc PHONE: Business 828-466-2300 Home

ADDRESS 3221 Hwy 70 West Newton, NC. 28658

LOCATION 115-21 N TR Oswalt Bridge Rd on (R) past 1st Harmon (R)

SUBDIVISION No BLOCK / SECTION LOT TRACT A LOT AREA 1.4 AC SITE CLASS. PS DESIGN FLOW 360 L.T.A.R. .3

Septic Tank: 1000 Gallons; STB 821 Date 7/6/06
Pump Tank: Gallons; PT Date
Pump Make: Model Serial No.
Nitrification Field: No Fields 1 Square Feet 1200 Linear Feet 400
No Lines 4@100 Trench Width 3' Max Trench Bottom Depth 3'

[X] New System [ ] Repair [ ] Expansion System Type: I II III IV V VI
System Description: Gravity Conventional
Repair System Description: 25% Reduced
Maintenance Agreement Required: [ ] Yes [X] No

[X] House/Mod. Home No. Bedrooms 3
[ ] Mobile Home No. Persons
[ ] Business No. Employees
[ ] Other


Water Supply: [X] Individual [ ] Public [ ] Community

Gravel Depth 1' [ ] Gravity [ ] Pressure [ ] Slab [X] Crawl Space [ ] Basement w/plumbing [ ] Basement wo/plumbing

Comments:/Conditions: Lines to follow contours. Driveway to go around Drainfield Area.


(1" = 60')

INITIAL SITE SKETCH

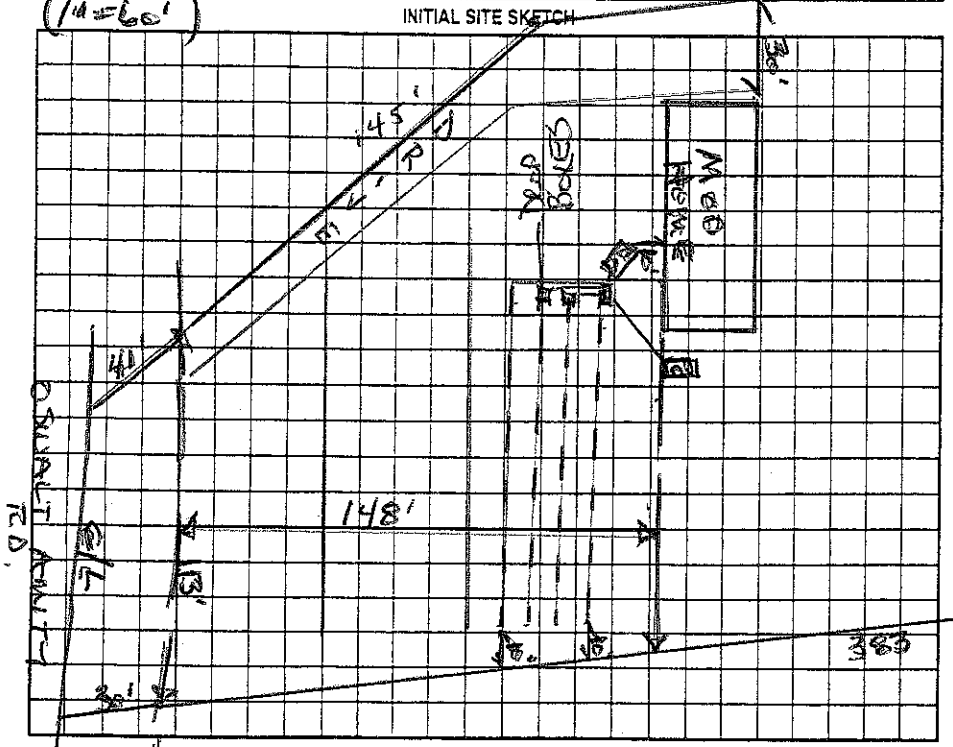

Comments:/Conditions: 300 FT EZFLOW INSTALLED AS ACCEPTED SYSTEM

AS BUILT SKETCH

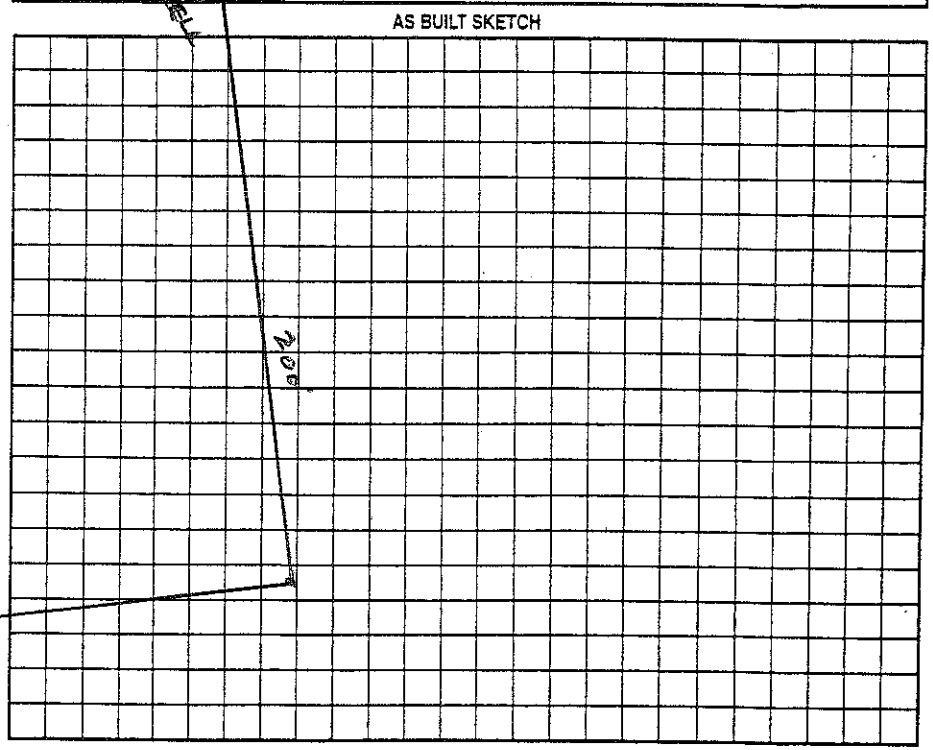

Permit can be suspended or revoked if any false information is supplied toward securing the permit/any unauthorized changes are made to the site/any unauthorized changes are made in the installation of the system. Improvement Permit with plat valid without expiration ☐ Improvement Permit with site plan valid for sixty months ☐ Authorization to Construct is valid for a period equal to that of Improvement Permit – not to exceed sixty months.

Signed: [signature] date 7-28-06 Installed by: Thomasville Grading

Improvement Permit by: Wesley Sparks RS date 7/24/06 Operation Permit by: Wesley Sparks RS date 8/17/06

Authorization to Construct by: Wesley Sparks RS date 7/24/06 Existing System Inspection by: date

HEALTH DEPT. COPY: WHITE OWNER COPY (FINAL): YELLOW OWNER COPY (INITIAL): PINK