pd 125 11-24-97

IREDELL COUNTY HEALTH DEPARTMENT

STATESVILLE 704-878-5305 MOORESVILLE 704-664-5281

IMPROVEMENT PERMIT / CERTIFICATE OF COMPLETION / OPERATION PERMIT / EXISTING SYSTEM INSPECTION

PROPERTY DESCRIPTION NO. 070365 DATE 11-21-97 TAX MAP NO. 4740 89 2185 (PT) Watershed: ☐ Yes ☑ No

OWNER OR CONTRACTOR DAVID R. STERRILL PHONE: Business Home 528-9425

ADDRESS 365 OSTWALT AMITY ROAD, TROUTMAN, NC 28166

LOCATION US 215, TL OSTWALT AMITY RD, 0.3 MILE ON LEFT AT BOX #173, BACK OFF 400'

SUBDIVISION BLOCK / SECTION LOT LOT AREA LIMITED SITE CLASS. PS DESIGN FLOW 360 L.T.A.R. 0.30 GPD/FT²

Septic Tank: 1000 Gallons; STB 794 Date 1-2-98

Pump Tank: Gallons; PT Date

Pump Make: Model Serial No.

Nitrification Field: No Fields I Square Feet EQ. TO 1200 Linear Feet 300+

No Lines THREE Trench Width 36" Max Trench Bottom Depth 30" Gravel Depth

☑ New System ☐ Repair System Type: I, II, III, IV, V, VI

System Description: CHAMBERED GRAVITY

Repair System Description: PPBPS PUMP FED

Maintenance Agreement Required: ☐ Yes ☑ No

☐ House/Mod. Home ☑ Mobile Home ☐ Business ☐ Other

No. Bedrooms 3 No. Bathrooms 2 No. Employees


☐ Slab ☑ Crawl Space ☐ Basement w/plumbing ☐ Basement wo/plumbing

Water Supply: ☑ Individual ☐ Community ☐ Public WELL

Comments: INSTALL FIFTY CHAMBERS IN THREE LINES AS SHOWN USING SERIAL DISTRIBUTION; NO DEEPER THAN 30"

Comments:

INITIAL SITE SKETCH

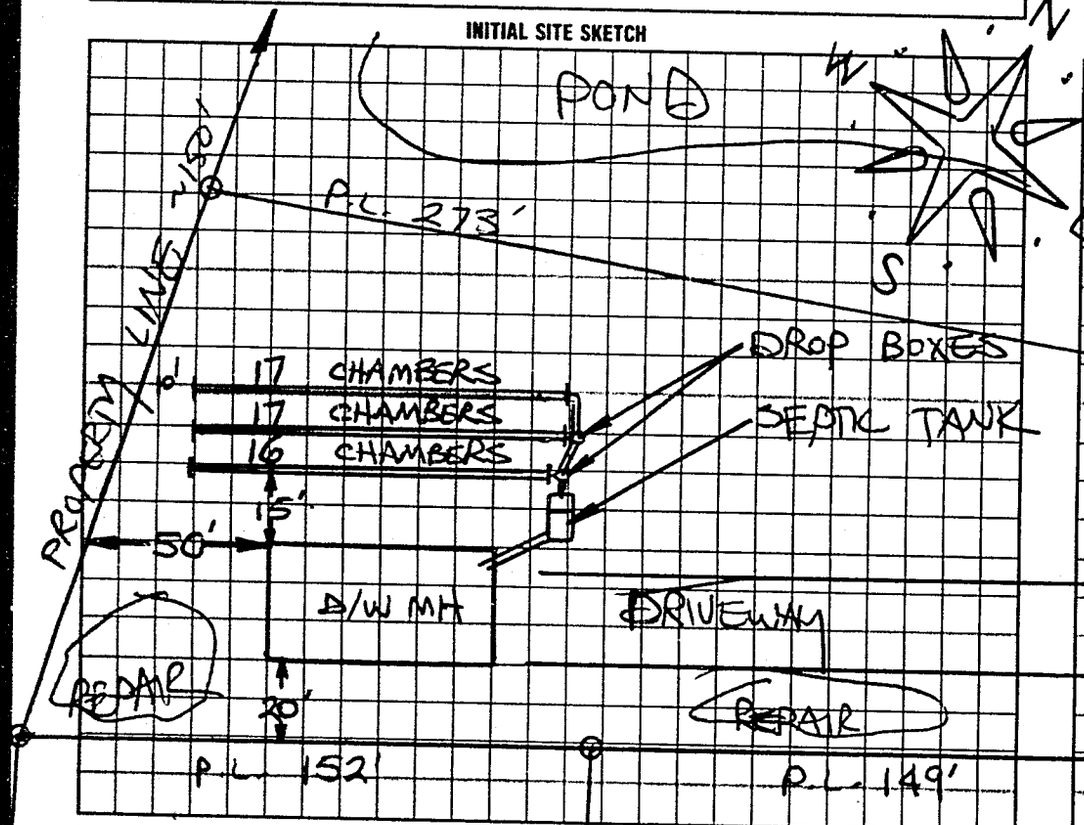

AS BUILT SKETCH

SYSTEM INSTALLED ACCORDING TO INITAL SITE SKETCH

I understand that this permit can be suspended or revoked if any false information is supplied toward securing the permit/any unauthorized changes are made to the site/any unauthorized changes are made in the installation of the system. Improvement Permit is valid for 60 months from date of issuance. AUTHORIZATION TO CONSTRUCT IS VALID FOR 60 MONTHS FROM DATE OF ISSUANCE.

Signed: Jane Shuril

Improvement Permit by: STEVE HENDRICK date 11-21-97

AUTH. TO CONST.

~~Existing System Inspection by:~~ STEVE HENDRICK date 11-21-97

Installed by: WES LYTTON

~~Certificate of Completion by:~~ date

Operation Permit by STEVE HENDRICK date 3-31-98

HEALTH DEPT COPY WHITE INSPECTION COPY (FINAL) GREEN OWNER COPY (FINAL) YELLOW INSPECTION COPY (INITIAL): PINK OWNER COPY (INITIAL): GOLD