IREDELL COUNTY HEALTH DEPARTMENT

Statesville Office (704) 878-5305 Mooresville Office (704) 660-3625 PERMIT # 200170

IMPROVEMENT PERMIT / AUTHORIZATION TO CONSTRUCT / OPERATION PERMIT / EXISTING SYSTEM

PIN # 4740597215

APPLICANT: Alice Reep APPLICANT ADDRESS: 195 Ostwalt Amity Rd.

SITE ADDRESS: 195 Ostwalt Amity Rd. PHONE: 704-508-1399 ALT. PHONE: N/A

SITE DIRECTIONS: Hwy 21S TL Ostwalt Amity Rd, Property on Left

SUBDIVISION: N/A SECTION: N/A LOT # N/A LOT AREA: 4.44 acres DESIGN FLOW: 240 gpd L.T.A.R.: Existing

Septic Tank 1000 (gal) STB 760-1000 Date 8-4-13
Pump Tank (gal) PT Date
Pump Make Model Serial #
Nitrification Fields Ex # Lines Ex Linear Ft: Ex
Trench Width Ex Max. Trench Bottom Depth Ex Gravel Depth Ex


☐ New System ☑ Repair ☐ Expansion System Type: I ☒ III IV V VI
System Description:
Repair System Description: TANK
Maintenance Agreement Required: ☐ YES ☑ NO
☑ GRAVITY ☐ PRESSURE

☑ Residence No. Bedrooms 2
☐ Business No. Persons
☐ Other No. Employees
☐ Slab ☐ Crawl Space
☑ Basement w/plumbing ☐ Basement w/o plumbing

Water Supply
☑ Private
☐ Public
☐ Community

Comments / Conditions: Set New 1000 gallon septic tank at location shown below to connect to existing nitrification field.

INITIAL SITE SKETCH

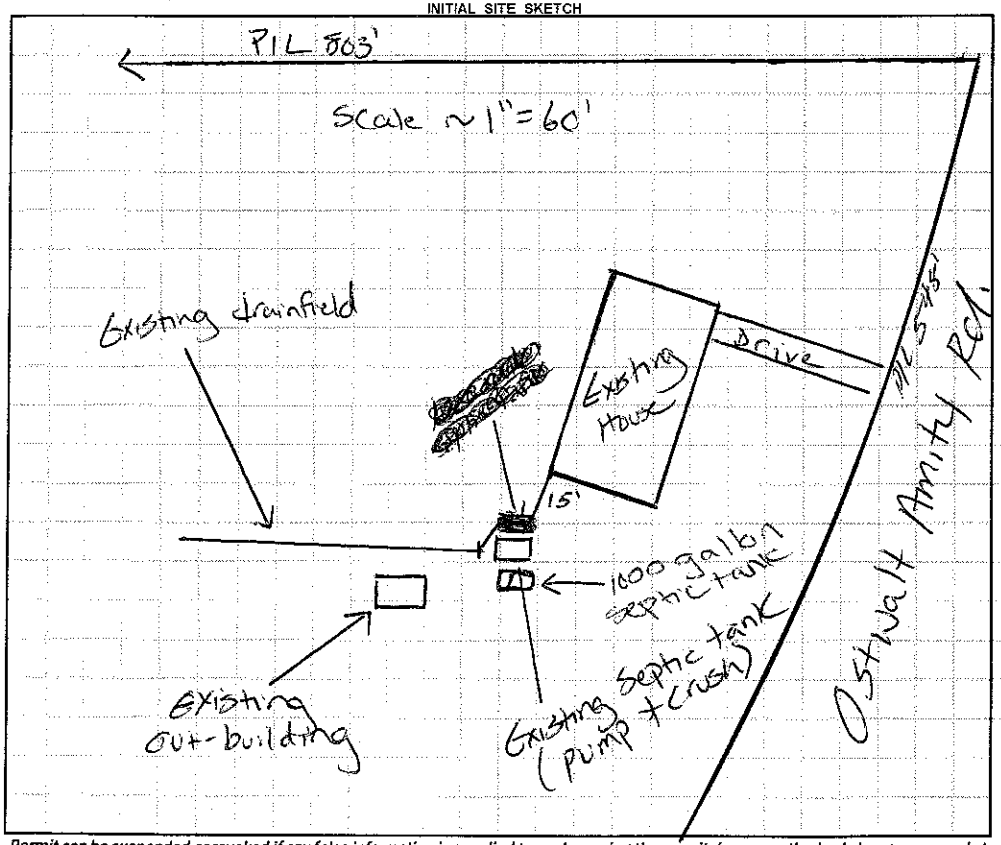

AS BUILT SKETCH

- Red Polylok filter installed
- Risers installed to grade
- Installed as drawn

Permit can be suspended or revoked if any false information is supplied toward securing the permit / any unauthorized changes are made to the site / any unauthorized changes are made in the installation of the system. **CONTACT A LOCATOR SERVICE PRIOR TO ANY EXCAVATION**

☐ **IMPROVEMENT PERMIT** *with plat* valid without expiration. ☑ **IMPROVEMENT PERMIT** *with site plan* valid for 60 mos. ☑ **AUTHORIZATION TO CONSTRUCT** valid for period equal to IMPROVEMENT PERMIT--not to exceed 60 mo.

Owner / Applicant Signature: Alice Reep Date: 11-19-13 Installed by: Jared Lentz

IMPROVEMENT PERMIT by: Justin Henderson Date: 11-18-13 OPERATION PERMIT by: Justin Henderson Date: 11-25-13

AUTHORIZATION TO CONSTRUCT by: Justin Henderson Date: 11-18-13 Existing System Inspected by: Date:

Health Dept. Copy - WHITE Applicant (Final Approval) - YELLOW Applicant (Conditional Approval) - PINK