IREDELL COUNTY HEALTH DEPARTMENT

STATESVILLE 704-878-5305 MOORESVILLE 704-664-5281

IMPROVEMENT PERMIT / AUTHORIZATION TO CONSTRUCT / OPERATION PERMIT / EXISTING SYSTEM INSPECTION

PERMIT# REPAIR PIN# — 4740 92 8700 DATE 2/23/98

OWNER OR CONTRACTOR JOY STUTTS PHONE: Business — Home 528-6771

ADDRESS 1100 STATESVILLE HWY

LOCATION 115/21 N - #1100 ON LEFT BEFORE WILCO.

SUBDIVISION — BLOCK / SECTION — LOT — LOT AREA — SITE CLASS. PS DESIGN FLOW 360 L.T.A.R. —

Septic Tank: 1000 Gallons; STB 794 Date 2/23/98

Pump Tank: — Gallons; PT — Date —

Pump Make: — Model — Serial No. —

Nitrification Field: No Fields 1 Square Feet 600 Linear Feet 40'

No Lines 1 BED Trench Width 15' Max Trench Bottom Depth BELOW OLD SYSTEM Gravel Depth 24"

☑ New System ☑ Repair System Type: I, II, III, IV, V, VI

System Description: (a)

Repair System Description: GRAVITY CONVENTIONAL

Maintenance Agreement Required: ☐ Yes ☑ No

☑ House/Mod. Home No. Bedrooms 3

☐ Mobile Home No. Bathrooms 2

☐ Business No. Employees —

☐ Other —

☐ Slab ☑ Crawl Space ☐ Basement w/plumbing ☐ Basement wo/plumbing


Water Supply: ☑ Individual ☐ Public ☐ Community

Comments:/Conditions:

Comments:/Conditions:

OLD SYSTEM SAVED AND USE ABOVE W/ NEW SYSTEM

INITIAL SITE SKETCH

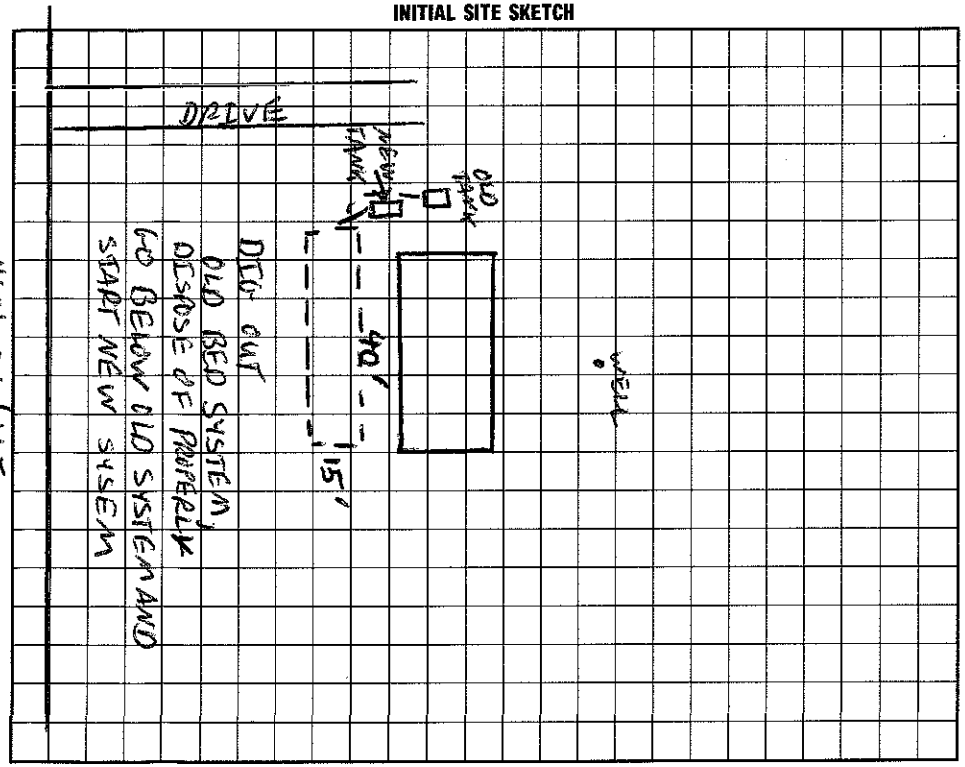

AS BUILT SKETCH

I understand that this permit can be suspended or revoked if any false information is supplied toward securing the permit/any unauthorized changes are made to the site/any unauthorized changes are made in the installation of the system. Improvement Permit with plat valid without expiration. Improvement Permit with site plan valid for sixty months. Authorization to Construct is valid for a period equal to that of Improvement Permit – not to exceed sixty months.

Signed: Randall B. Stutts date 2/23/98 Installed by: FJ ERVIN

Improvement Permit by: C. [signature] date 2/23/98 Operation Permit by: — date —

Authorization to Construct by: C. [signature] date 2/23/98 Existing System Inspection by: — date —

HEALTH DEPT. COPY: WHITE INSPECTION COPY (FINAL): GREEN OWNER COPY (FINAL): YELLOW INSPECTION COPY (INITIAL): PINK OWNER COPY (INITIAL): GOLD