1730

IREDELL COUNTY HEALTH DEPARTMENT

STATESVILLE 704-878-5305 MOORESVILLE 704-664-5281

IMPROVEMENT PERMIT / AUTHORIZATION TO CONSTRUCT / OPERATION PERMIT / EXISTING SYSTEM INSPECTION

PERMIT# 072740 PIN# 4740 97 0967 DATE 10/5/98

OWNER OR CONTRACTOR Koontz Construction PHONE: Business 662-6556 Home

ADDRESS 191 Kents Rd. Mooresville, NC. 28115

LOCATION Houston Rd; 115 N TR Houston Rd., last lot on (L) before 1st house

SUBDIVISION Park 42 BLOCK / SECTION — LOT 8 LOT AREA 1.36 SITE CLASS. PS DESIGN FLOW 250 L.T.A.R. .3

Septic Tank: 1000 Gallons; STB 794 Date 6/5/99
Pump Tank: 1000 Gallons; PT 27 Date 7/4/99
Pump Make: Goulds Model WO3WE03 Serial No. A9921108
Nitrification Field: No Fields 1 Square Feet 810 Linear Feet 270
No Lines 3 Trench Width 36 Max Trench Bottom Depth 36" Gravel Depth 12"

[X] New System [ ] Repair System Type: I, II, (III) IV, V, VI
System Description: Pres Man — Conventional
Repair System Description: Same
Maintenance Agreement Required: [ ] Yes [X] No

[ ] House/Mod. Home No. Bedrooms
[ ] Mobile Home No. Bathrooms
[X] Business No. Employees 10
[X] Other


[ ] Slab [X] Crawl Space [ ] Basement w/plumbing [ ] Basement wo/plumbing

Water Supply:
[X] Individual
[ ] Public
[ ] Community


Comments:/Conditions: Filter a riser installed.

Comments:/Conditions: Tanks lines & Pressure head tested 8/10/99. MS

INITIAL SITE SKETCH

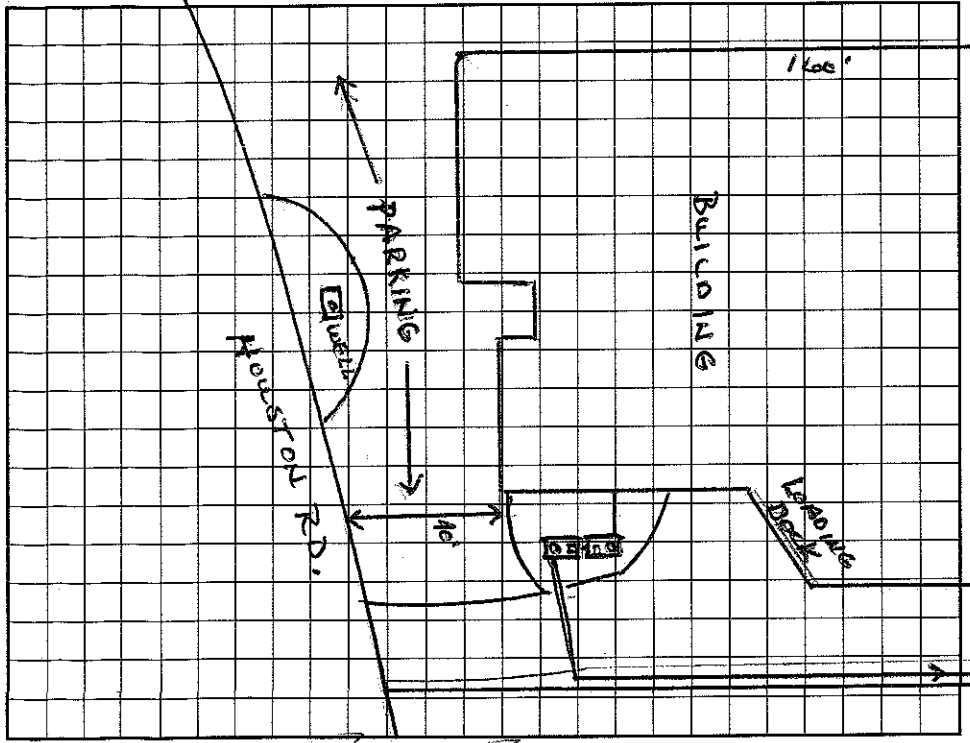

AS BUILT SKETCH

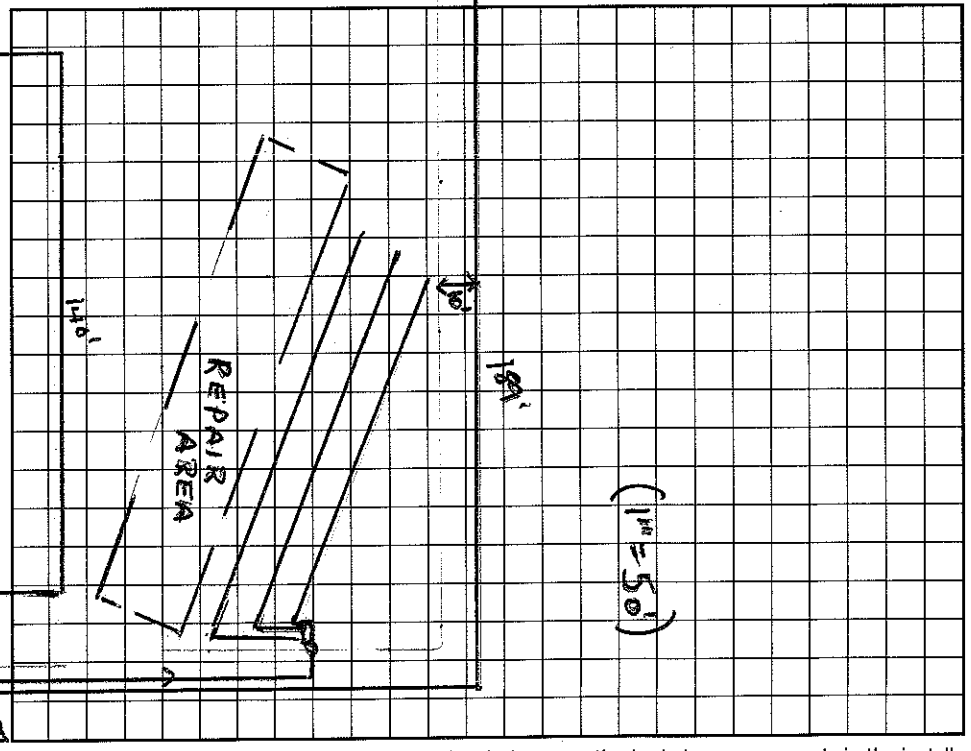

I understand that this permit can be suspended or revoked if any false information is supplied toward securing the permit/any unauthorized changes are made to the site/any unauthorized changes are made in the installation of the system. Improvement Permit with plat valid without expiration. Improvement Permit with site plan valid for sixty months. Authorization to Construct is valid for a period equal to that of Improvement Permit – not to exceed sixty months.

Signed: [signature] date 10/7/98 Installed by: F.J. Ervin

Improvement Permit by: Wesley Sparks RS. date 10/5/98 Operation Permit by: Wesley Sparks RS. date 11/8/99

Authorization to Construct by: Wesley Sparks RS. date 10/5/98 Existing System Inspection by: date

HEALTH DEPT. COPY: WHITE INSPECTION COPY (FINAL): GREEN OWNER COPY (FINAL): YELLOW INSPECTION COPY (INITIAL): PINK OWNER COPY (INITIAL): GOLD