4740973546

IREDELL COUNTY HEALTH DEPARTMENT

STATESVILLE 704-878-5305 MOORESVILLE 704-664-5281

IMPROVEMENT PERMIT / CERTIFICATE OF COMPLETION / OPERATION PERMIT / EXISTING SYSTEM INSPECTION

PROPERTY DESCRIPTION NO. 19277 DATE 8/26/94 TAX MAP NO. 4F-A-9 Watershed: ☐ Yes ☑ No

OWNER OR CONTRACTOR Lawrence M Reid PHONE: Business _____ Home 528-4108

ADDRESS PO Box 1156 Troutman, NC. 28166

LOCATION Houston Rd on (R) at church sign TR Tomlinson (L) in field

SUBDIVISION N/A BLOCK / SECTION _____ LOT N/A LOT AREA ~ 5 Ac SITE CLASS. P DESIGN FLOW 360 L.T.A.R. .3

Septic Tank: 1000 Gallons; STB 794 Date 8/30/94
Pump Tank: _____ Gallons; PT _____ Date _____
Pump Make: _____ Model _____ Serial No. _____
Nitrification Field: No Fields 1 Square Feet 1200 Linear Feet 400
No Lines 4 Trench Width 36" Max Trench Bottom Depth 30" Gravel Depth 6"

☑ New System ☐ Repair System Type: I (II) III, IV, V, VI
System Description: DIST Box - Conv
Repair System Description: Same
Maintenance Agreement Required: ☐ Yes ☐ No


☑ House/Mod. Home No. Bedrooms 3
☐ Mobile Home No. Bathrooms 2
☐ Business No. Employees _____
☐ Other _____
☐ Slab ☑ Crawl Space ☐ Basement w/plumbing ☐ Basement wo/plumbing

Water Supply:
☑ Individual
☐ Community
☐ Public
from house

Comments: Speed Levelers required
Keep trenches no deeper than 30" to trench bottom.
Cover as finished grade is sloped to drain

Comments:
3 - 133' x 3' Lines

INITIAL SITE SKETCH

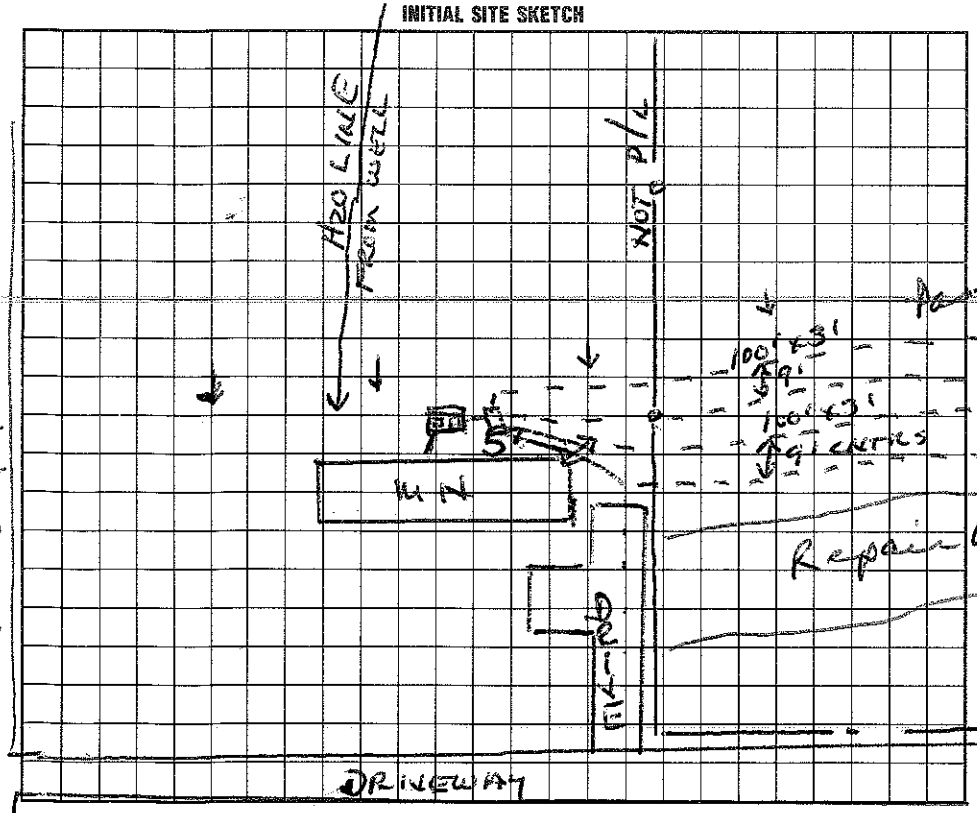

AS BUILT SKETCH

I understand that this permit can be suspended or revoked if any false information is supplied toward securing the permit/any unauthorized changes are made to the site/any unauthorized changes are made in the installation of the system. Improvement Permit is valid for 60 months from date of issuance.

Signed: X Lawrence M. Reid

Improvement Permit by: Wesley Sparks RS. date 8/26/94

Existing System Inspection by: _____ date _____

Installed by: F J Enis

Certificate of Completion by: Wesley Sparks RS. date 9/27/94

Operation Permit by: _____ date _____

HEALTH DEPT. COPY: WHITE INSPECTION COPY (FINAL): GREEN OWNER COPY (FINAL): YELLOW INSPECTION COPY (INITIAL): PINK OWNER COPY (INITIAL): GOLD