IREDELL COUNTY HEALTH DEPARTMENT - *ENVIRONMENTAL HEALTH* ☐ STATESVILLE OFFICE 704-878-5305 ☐ MOORESVILLE OFFICE 704-664-5281

IMPROVEMENT PERMIT / AUTHORIZATION TO CONSTRUCT / OPERATION PERMIT / EXISTING SYSTEM INSPECTION

PERMIT # Repair PIN # 4741-02-0639 DATE 28 March 11

OWNER Todd and Amy Hauser APPLICANT: PHONE: Home/Cell # (704) 928-6780 Business #

SITE ADDRESS 224 Era Street Troutman OWNER / APPLICANT ADDRESS

SITE DIRECTIONS Perth Rd. From Hwy 21 - TL Era St. 6/10 to End.

SUBDIVISION BLOCK / SECTION LOT # LOT AREA 1 ac. DESIGN FLOW 480 gpd L.T.A.R. 0.3/A/D

Septic Tank Exist. Gallons: STB Date

Pump Tank Gallons: P T Date

Pump Make Model Serial #

No. Nitrification Fields: 1 No. Lines 5 Linear Feet 400

Trench Width 36" Max. Trench Bottom Depth 36" Gravel Depth N/A

☐ New System ☑ Repair ☐ Expansion System Type I II III IV V VI

System Description: Exist. - Conv. Gravity System

Repair System Description: 25% Reduction System

Maintenance Agreement Required ☐ YES ☑ NO

☑ GRAVITY ☐ PRESSURE

☑ Residence No. Bedrooms 4

☐ Business No. Persons

☐ Other No. Employees


☐ Slab ☑ Crawl Space

☐ Basement w/plumbing ☐ Basement w/o plumbing

Water Supply: ☐ Private ☑ Public ☐ Community

Comments / Conditions

INITIAL SITE SKETCH

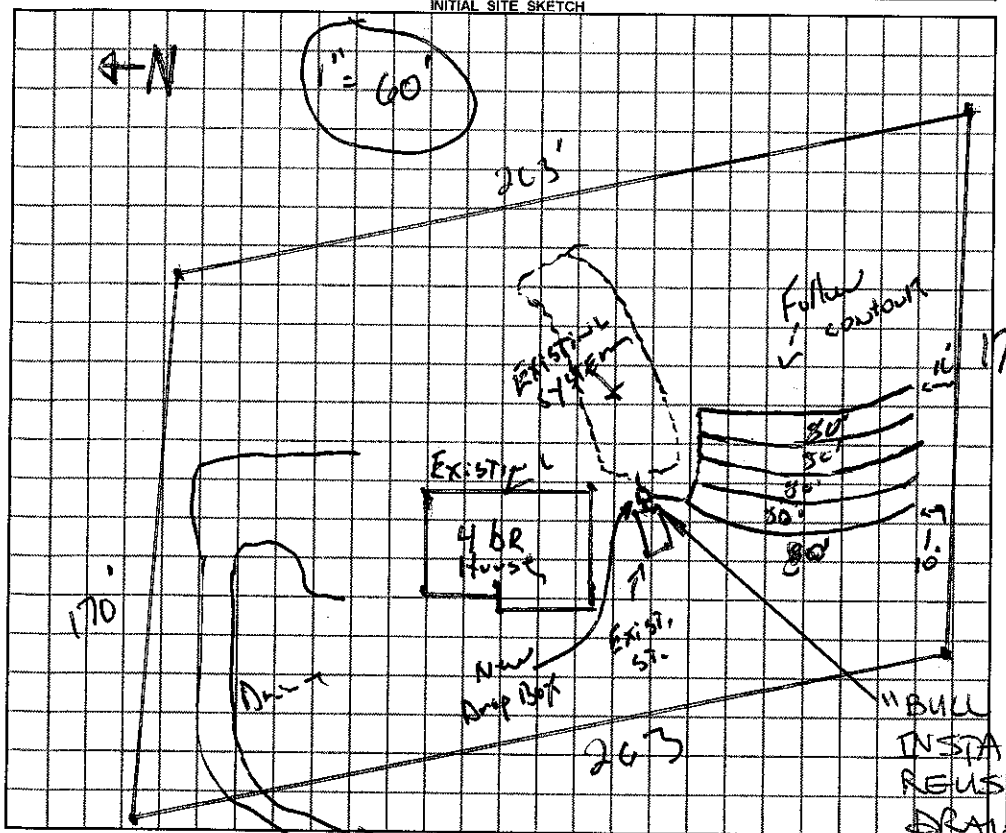

AS BUILT SKETCH

SYSTEM REPAIRED ACCORDING TO INITIAL SITE SKETCH

"BULL RUN" VALVE INSTALLED ALLOWING REUSE OF EXISTING DRAINFIELD

Permit can be suspended or revoked if any false information is supplied toward securing the permit / any unauthorized changes are made to the site / any unauthorized changes are made in the installation of the system.

☐ ***IMPROVEMENT PERMIT*** *with plat valid without expiration.* ☑ ***IMPROVEMENT PERMIT*** *with ~~plat valid without expiration.~~ site plan valid 60 mo.* ☑ ***AUTHORIZATION TO CONSTRUCT*** valid for period equal to IMPROVEMENT PERMIT--not to exceed 60 mo.

Owner / Applicant Signature: Todd Hauser Date 5-30-11

IMPROVEMENT PERMIT by: REHS Date 28 March 11

AUTHORIZATION TO CONSTRUCT by: REHS Date 28 March 11

YOU SHOULD CONTACT A LOCATOR SERVICE PRIOR TO ANY EXCAVATION

Installed by: C. WAYNE ORBISON & SONS, INC

OPERATION PERMIT by: STEVE HENDRICK REHS Date 9-20-11

Existing System Inspected by: REHS Date

White Copy -- Environmental Health YELLOW COPY (Final) Owner / Applicant PINK COPY (Initial) Owner / Applicant