REDELL COUNTY HEALTH DEPARTMENT

STATESVILLE 704-878-5305 — MOORESVILLE 704-664-5281

Void Previous Permits

IMPROVEMENT PERMIT / AUTHORIZATION TO CONSTRUCT / OPERATION PERMIT / EXISTING SYSTEM INSPECTION

PERMIT# 01 Z 899/84296 PIN# 4741 12 5858

OWNER OR CONTRACTOR GARY L. LAMBERTH PHONE: Business _____ Home 528-6767 DATE Feb 21 2000

ADDRESS 163 Pine State Rd TROUTMAN N/C

LOCATION Hwy 21 South (R) Pine State Rd Lot on Left Toward End

SUBDIVISION _____ BLOCK / SECTION _____ LOT _____ LOT AREA .8Ac SITE CLASS PS DESIGN FLOW 360 L.T.A.R. .3

Septic Tank: 1000 Gallons; STB 312 Date 1-7-2000
Pump Tank: _____ Gallons; PT _____ Date _____
Pump Make: _____ Model _____ Serial No. _____
Nitrification Field: No Fields 1 Square Feet 1200 Linear Feet 400
No Lines 4 Trench Width 36" Max Trench Bottom Depth 36"

☒ New System ☐ Repair System Type: I. II. III. IV. V. VI
System Description: GRAVITY Conventional
Repair System Description: GRAVITY Reduction
Maintenance Agreement Required: ☐ Yes ☒ No
Gravel Depth 12"


☒ House/Mod. Home No. Bedrooms 3
☐ Mobile Home No. Bathrooms 2
☐ Business No. Employees _____
☐ Other _____
☐ Slab ☒ Crawl Space ☐ Basement w/plumbing ☐ Basement wo/plumbing

Water Supply: ☒ Individual ☐ Public ☐ Community — Well


Comments:/Conditions: INSTALL on CONTOUR
MAY US DISTRIBUTION box w/ speed Levels
Dig Through old Lines if encountered Backfill
Pump & Fill in old tank
Crush

Comments /Conditions:

INITIAL SITE SKETCH

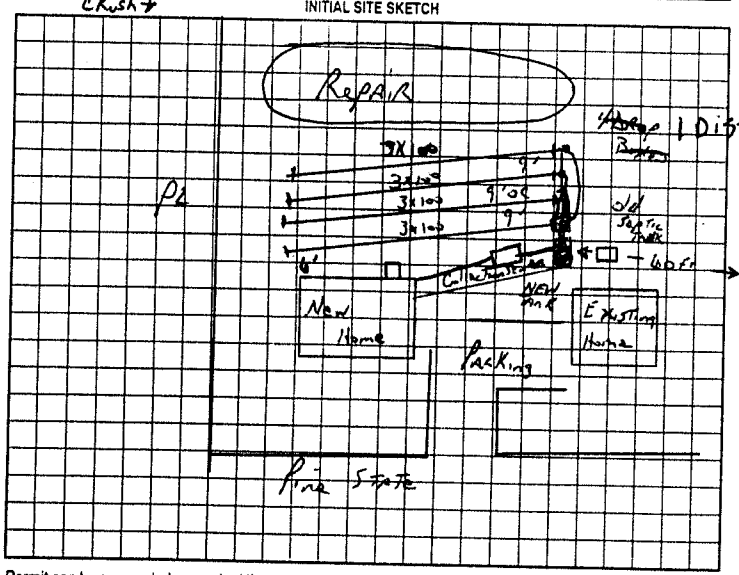

AS BUILT SKETCH

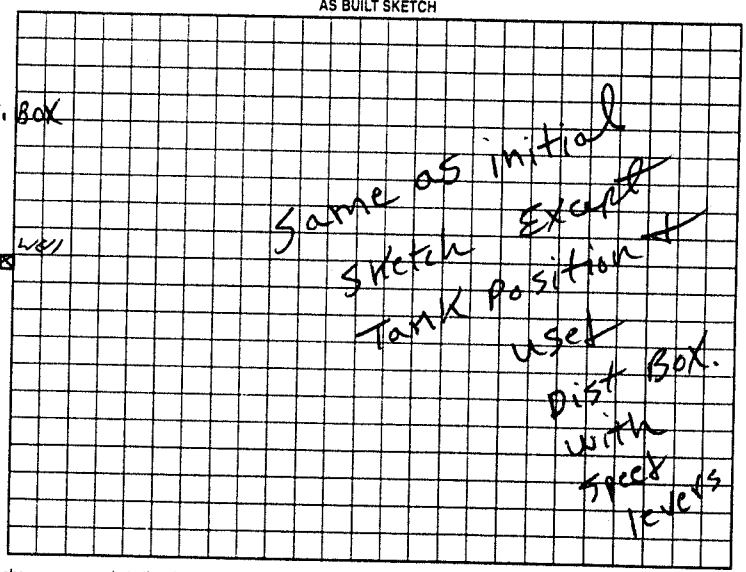

Permit can be suspended or revoked if any false information is supplied toward securing the permit/any unauthorized changes are made to the site/any unauthorized changes are made in the installation of the system. Improvement Permit with plat valid without expiration. Improvement Permit with site plan valid for sixty months. Authorization to Construct is valid for a period equal to that of Improvement Permit – not to exceed sixty months.

Signed: _____ date 2-22-00 Installed by: Wayne Oribson

Improvement Permit by: J.C. Potter date Feb 21 2000 Operation Permit by: P. E. Moore date 4-17-00

Authorization to Construct by: J.C. Potter date Feb 21 2000 Existing System Inspection by: _____ date _____

HEALTH DEPT. COPY: WHITE OWNER COPY (FINAL): YELLOW OWNER COPY (INITIAL): PINK