80946

IREDELL COUNTY HEALTH DEPARTMENT

STATESVILLE 704-878-5305 MOORESVILLE 704-664-5281

IMPROVEMENT PERMIT / AUTHORIZATION TO CONSTRUCT / OPERATION PERMIT / EXISTING SYSTEM INSPECTION

PERMIT# 09 7 299 Troutman PIN# 4741161168 DATE 3-19-99

OWNER OR CONTRACTOR New Port Professional Center PHONE: Business 872 4445 Home

ADDRESS 1118-A River Hwy mooresville N.C.

LOCATION US 21 Turn wine co 65 St. Troutman

SUBDIVISION Eastern Heights BLOCK / SECTION LOT 18 LOT AREA V 140000 sq' SITE CLASS PS DESIGN FLOW 360 L.T.A.R. .3

Septic Tank: 1000 Gallons: STB 97 Date 8-3 99

Pump Tank: Gallons: PT Date

Pump Make: Model Serial No.

Nitrification Field: No Fields 1 Square Feet 400 Linear Feet 200

No Lines 4 Trench Width 24" Max Trench Bottom Depth 36" Gravel Depth N/A

☑ New System ☐ Repair System Type: I II III IV V VI

System Description: Gravity Panels

Repair System Description: " "

Maintenance Agreement Required: ☐ Yes ☐ No

☐ Slab ☑ Crawl Space ☐ Basement w/plumbing ☐ Basement wo/plumbing

☑ House/Mod. Home No. Bedrooms 3

☐ Mobile Home No. Bathrooms 2

☐ Business No. Employees


☐ Other

Water Supply: ☐ Individual ☑ Public ☐ Community


Comments/Conditions:

Comments/Conditions

INITIAL SITE SKETCH

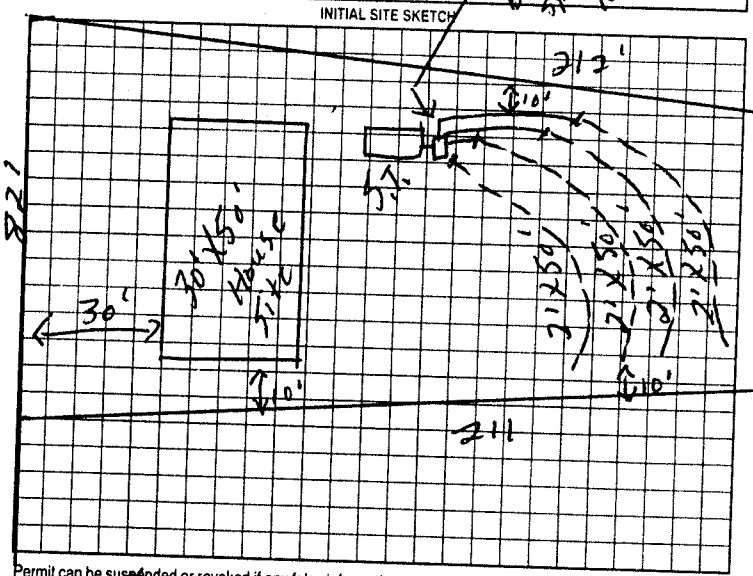

AS BUILT SKETCH

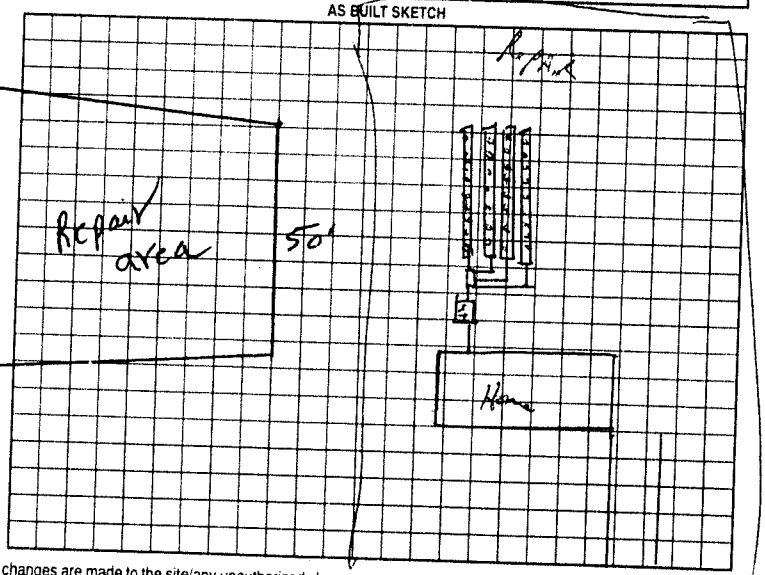

Permit can be suspended or revoked if any false information is supplied toward securing the permit/any unauthorized changes are made to the site/any unauthorized changes are made in the installation of the system. Improvement Permit with plat valid without expiration. Improvement Permit with site plan valid for sixty months. Authorization to Construct is valid for a period equal to that of Improvement Permit – not to exceed sixty months.

Signed: _____ date _____ Installed by: Perry Laney

Improvement Permit by: F.C. moore date 3-19-99 Operation Permit by: _____ date Oct 19 99

Authorization to Construct by: F.C. moore date 3-19-99 Existing System Inspection by: _____ date _____

HEALTH DEPT. COPY WHITE OWNER COPY (FINAL) YELLOW OWNER COPY (INITIAL) PINK