80942

IREDELL COUNTY HEALTH DEPARTMENT

STATESVILLE 704-878-5305 MOORESVILLE 704-664-5281

IMPROVEMENT PERMIT / AUTHORIZATION TO CONSTRUCT / OPERATION PERMIT / EXISTING SYSTEM INSPECTION

PERMIT# 06-2-299 PIN# 4741161484 DATE 10-25-99

OWNER OR CONTRACTOR New Port Professional Center PHONE: Business 892-4445 Home

ADDRESS 1118-A River Hwy mooresville, N.C.

LOCATION US 21 Turn wirecoss St. Troutman N.C.

SUBDIVISION Eastern Heights BLOCK / SECTION LOT 15 LOT AREA 24800 SITE CLASS PS DESIGN FLOW 360 L.T.A.R. .3

Septic Tank: 1000 Gallons; STB 97 Date 9-21-99
Pump Tank: Gallons; PT Date
Pump Make: Model Serial No.
Nitrification Field: No Fields 1 Square Feet 1200 Linear Feet 400
No Lines 4 Trench Width 36" Max Trench Bottom Depth 36" Gravel Depth 12"

☐ New System ☐ Repair System Type: I, II, III, IV, V, VI
System Description: Gravity Conv.
Repair System Description: Pump To 25% Reduct
Maintenance Agreement Required: ☐ Yes ☐ No


☒ House/Mod. Home No. Bedrooms 3
☐ Mobile Home No. Bathrooms 2
☐ Business No. Employees
☐ Other
☐ Slab ☐ Crawl Space ☐ Basement w/plumbing ☐ Basement wo/plumbing

Water Supply: ☐ Individual ☒ Public ☐ Community

Comments:/Conditions: Replaces Permit issued 3-19-99

Comments:/Conditions:

INITIAL SITE SKETCH 213'

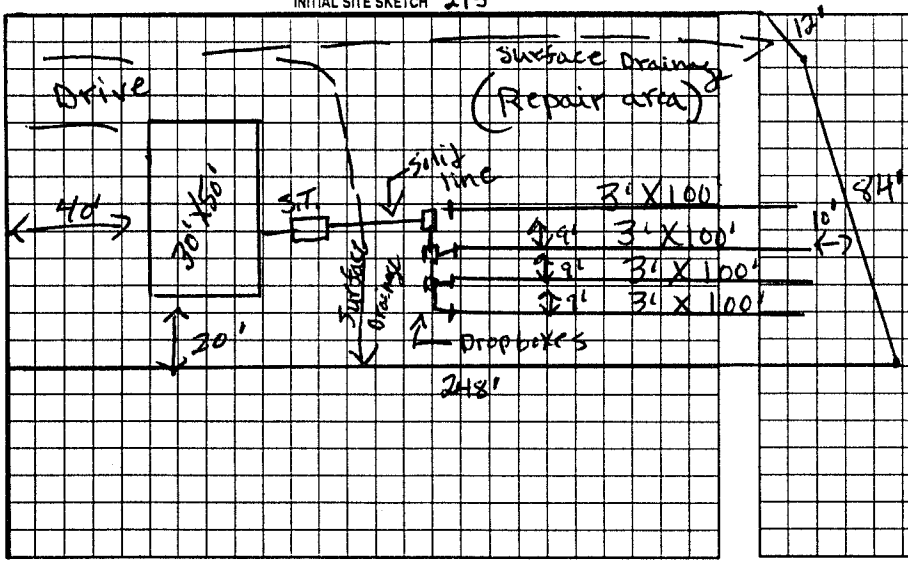

AS BUILT SKETCH

Same as initial sketch

Permit can be suspended or revoked if any false information is supplied toward securing the permit/any unauthorized changes are made to the site/any unauthorized changes are made in the installation of the system. Improvement Permit with plat valid without expiration. Improvement Permit with site plan valid for sixty months. Authorization to Construct is valid for a period equal to that of Improvement Permit – not to exceed sixty months.

Signed: date Installed by: Perry Laney

Improvement Permit by: R.C. Moore date 10-25-99 Operation Permit by: R.C. Moore date 11-12-99

Authorization to Construct by: R.C. Moore date 10-25-99 Existing System Inspection by: date

HEALTH DEPT. COPY: WHITE OWNER COPY (FINAL): YELLOW OWNER COPY (INITIAL): PINK