IREDELL COUNTY HEALTH DEPARTMENT

STATESVILLE 704-878-5305 MOORESVILLE 704-664-5281

IMPROVEMENT PERMIT / AUTHORIZATION TO CONSTRUCT / OPERATION PERMIT / EXISTING SYSTEM INSPECTION

PERMIT# 08-2-0198 PIN# 1604mo1000 A024 Troutman NC DATE 9-16-99

OWNER OR CONTRACTOR Jim R. Jones PHONE: Business 660 6710 Home

ADDRESS 496 main St. Troutman, N.C.

LOCATION US 21 S To Troutman TR Autumn leaf TL Trellis TL Viking 3rd lot L

SUBDIVISION Normandy Brooks BLOCK / SECTION LOT 4+5 LOT AREA 1.3 acres SITE CLASS PS DESIGN FLOW 360 L.T.A.R. .3

Septic Tank: 1000 Gallons; STB 312 Date 9-27-99
Pump Tank: Gallons; PT Date
Pump Make: Model Serial No.
Nitrification Field: No Fields 1 Square Feet 900 Linear Feet 300
No Lines 3 Trench Width 36" Max Trench Bottom Depth 36" Gravel Depth N/a

☑ New System ☐ Repair System Type: I II III IV V VI
System Description: Gravity 25% Reduction
Repair System Description: " " " chambers or Equiv
Maintenance Agreement Required: ☐ Yes ☑ No


☑ House/Mod. Home No. Bedrooms 3
☐ Mobile Home No. Bathrooms 2
☐ Business No. Employees
☐ Other

Water Supply: ☑ Individual ☐ Public ☐ Community

☐ Slab ☑ Crawl Space ☐ Basement w/plumbing ☐ Basement wo/plumbing

Comments/Conditions:


INITIAL SITE SKETCH

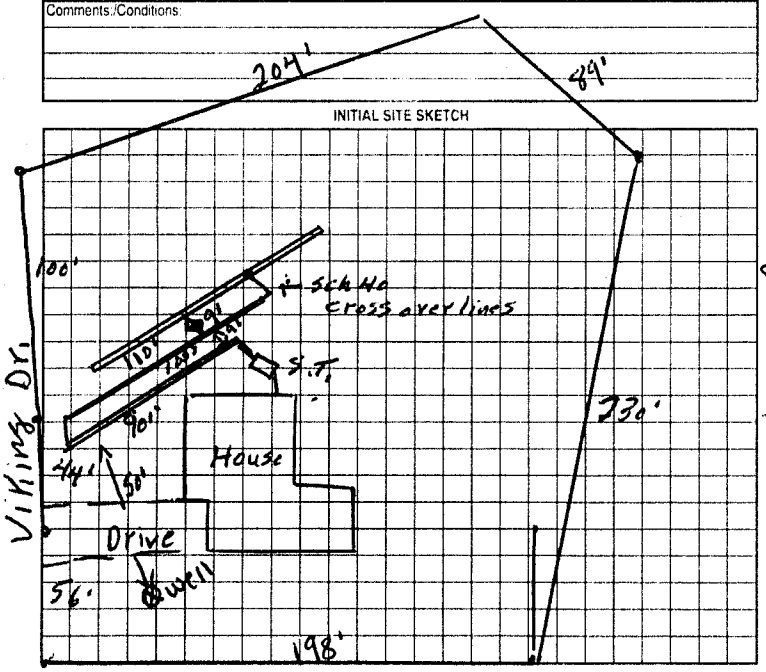

Comments/Conditions

Divert Surface water around system

AS BUILT SKETCH

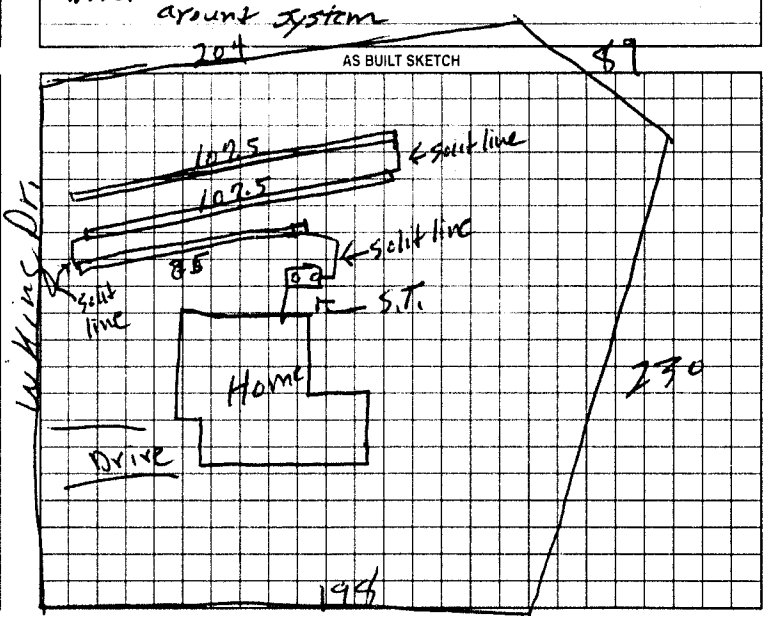

Permit can be suspended or revoked if any false information is supplied toward securing the permit/any unauthorized changes are made to the site/any unauthorized changes are made in the installation of the system. Improvement Permit with plat valid without expiration. Improvement Permit with site plan valid for sixty months. Authorization to Construct is valid for a period equal to that of Improvement Permit – not to exceed sixty months.

Signed: [signature] date 11-24-99 Installed by: DC Court Denver N.C.

Improvement Permit by: P. C. Moore date 9-16-99 Operation Permit by: P. C. Moore date 12-9-99

Authorization to Construct by: P. C. Moore date 9-16-99 Existing System Inspection by: date

HEALTH DEPT COPY WHITE OWNER COPY (FINAL) YELLOW OWNER COPY (INITIAL) PINK