IREDELL COUNTY HEALTH DEPARTMENT

STATESVILLE 704-878-5305 MOORESVILLE 704-664-5281

IMPROVEMENT PERMIT / AUTHORIZATION TO CONSTRUCT / OPERATION PERMIT / EXISTING SYSTEM INSPECTION

PERMIT# REPAIR PIN# 4741 22 7687 DATE 10-20-2000

OWNER OR CONTRACTOR CURTIS SHERRILL PHONE: Business Home 528-6963

ADDRESS 135 AUTUMN LEAF ROAD, TROUTMAN, NC 28166

LOCATION US 21 SOUTH, TR AUTUMN LEAF ROAD, 8TH HOUSE ON LEFT

SUBDIVISION BLOCK / SECTION LOT LOT AREA 102' x 150' SITE CLASS. PS DESIGN FLOW 240 L.T.A.R. EXISTING

Septic Tank: ~~EXISTING~~ Gallons: STB Date

Pump Tank: Gallons: PT Date

Pump Make: Model Serial No.

Nitrification Field: No Fields 1 Square Feet 540 Linear Feet 160

No Lines FOUR Trench Width 36" Max Trench Bottom Depth 36" Gravel Depth 24"

☐ New System ☑ Repair System Type: I (II) III IV V VI

System Description: CONVENTIONAL GRAVITY

Repair System Description: CONVENTIONAL GRAVITY

Maintenance Agreement Required: ☐ Yes ☑ No

☑ House/Mod. Home No. Bedrooms 2

☐ Mobile Home No. Bathrooms 1

☐ Business No. Employees

☐ Other


☐ Slab ☐ Crawl Space ☐ Basement w/plumbing ☑ Basement wo/plumbing

Water Supply: ☑ Individual ☐ Public ☐ Community WELL ACROSS ROAD


Comments/Conditions: ① INSTALL NEW SANITARY TEE IN SEPTIC TANK. ② INSTALL NEW LINES AS SHOWN USING 24" STONE. ③ KEEP SYSTEM MINIMUM 50' FROM WELLS.

Comments/Conditions: THIS PERMIT SERVES AS "NOTICE OF VIOLATION"

INITIAL SITE SKETCH

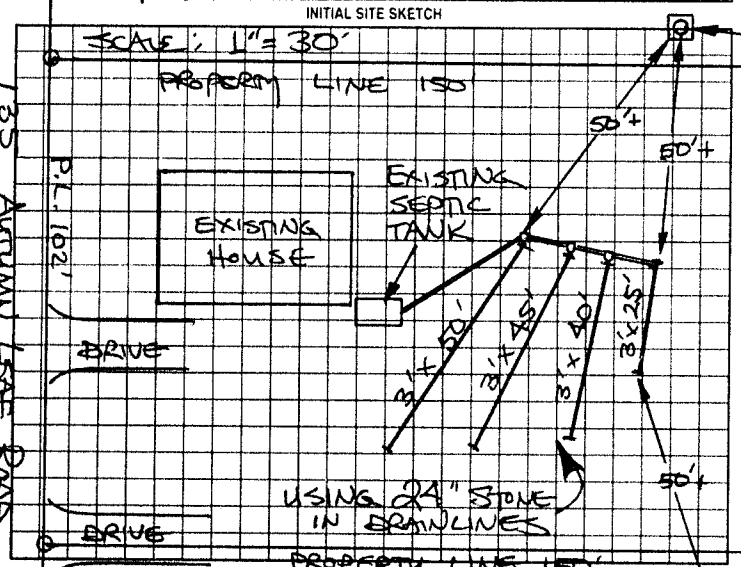

AS BUILT SKETCH

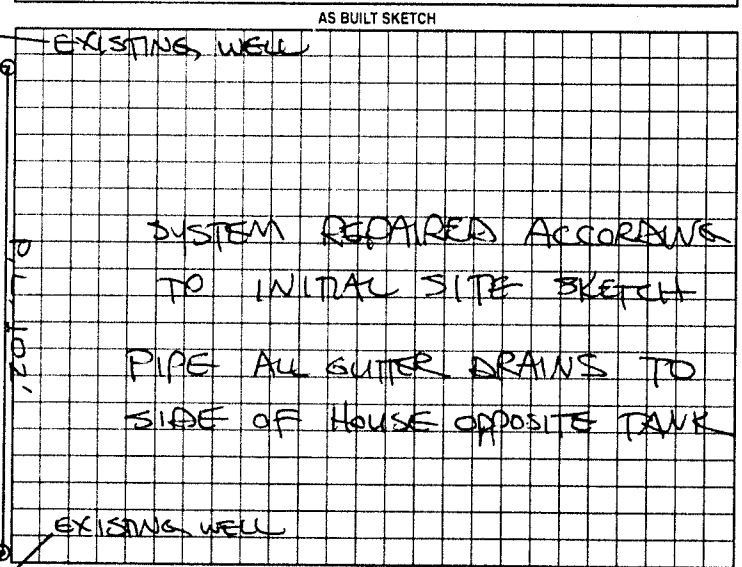

Permit can be suspended or revoked if any false information is supplied toward securing the permit/any unauthorized changes are made to the site/any unauthorized changes are made in the installation of the system. Improvement Permit with plat valid without expiration. Improvement Permit with site plan valid for sixty months. Authorization to Construct is valid for a period equal to that of Improvement Permit -- not to exceed sixty months.

Signed: [signature] date 10/30/00 Installed by: WES CUTTON

Improvement Permit by: STEVE HENDRICK date 10-20-2000 Operation Permit by: STEVE HENDRICK date 12-12-00

Authorization to Construct by: STEVE HENDRICK date 10-20-2000 Existing System Inspection by: date

HEALTH DEPT COPY WHITE OWNER COPY (FINAL) YELLOW OWNER COPY (INITIAL) PINK