IREDELL COUNTY HEALTH DEPARTMENT

STATESVILLE 704-878-5305 CI ∅ MOORESVILLE 704-664-5281

IMPROVEMENT PERMIT / AUTHORIZATION TO CONSTRUCT / OPERATION PERMIT / EXISTING SYSTEM INSPECTION

PERMIT# ~~Troutman~~ 13622 PIN# 4741237354 DATE 4/13/05

OWNER OR CONTRACTOR Troutman Church of God PHONE: Business 704 528 5175 Home

ADDRESS PO Box 488 Troutman NC 28166

LOCATION 115 S, on Rt at Corner of Autumn Leaf

SUBDIVISION BLOCK / SECTION LOT LOT AREA SITE CLASS. PS DESIGN FLOW 545 L.T.A.R. —

GT ~~Pump Tank~~: 1500 Gallons; PT 1011 Date 1-28-06

Septic Tank: 1500 Gallons; STB 1011 Date 7-29-99

Pump Make: Model Serial No.

Nitrification Field: No Fields Square Feet Linear Feet

No Lines Trench Width Max Trench Bottom Depth Gravel Depth

☐ New System ☐ Repair System Type: I, (II), III, IV, V, VI

System Description: Existing Conventional Bed

Repair System Description: Pump 25% Reduct.

Maintenance Agreement Required: ☐ Yes ☒ No

☐ House/Mod. Home No. Bedrooms

☐ Mobile Home No. Bathrooms

☐ Business No. Employees

☒ Other Church Fellowship Hall

☒ Slab ☐ Crawl Space ☐ Basement w/plumbing ☐ Basement wo/plumbing


Water Supply: ☐ Individual ☐ Public ☐ Community

Comments:/Conditions: NOT Adding to Membership (109 members) Autumn Leaf

Comments:/Conditions: Kitchen Plumbed to Grease Trap
Other Plumbing to Septic Tank

INITIAL SITE SKETCH

Not to Scale

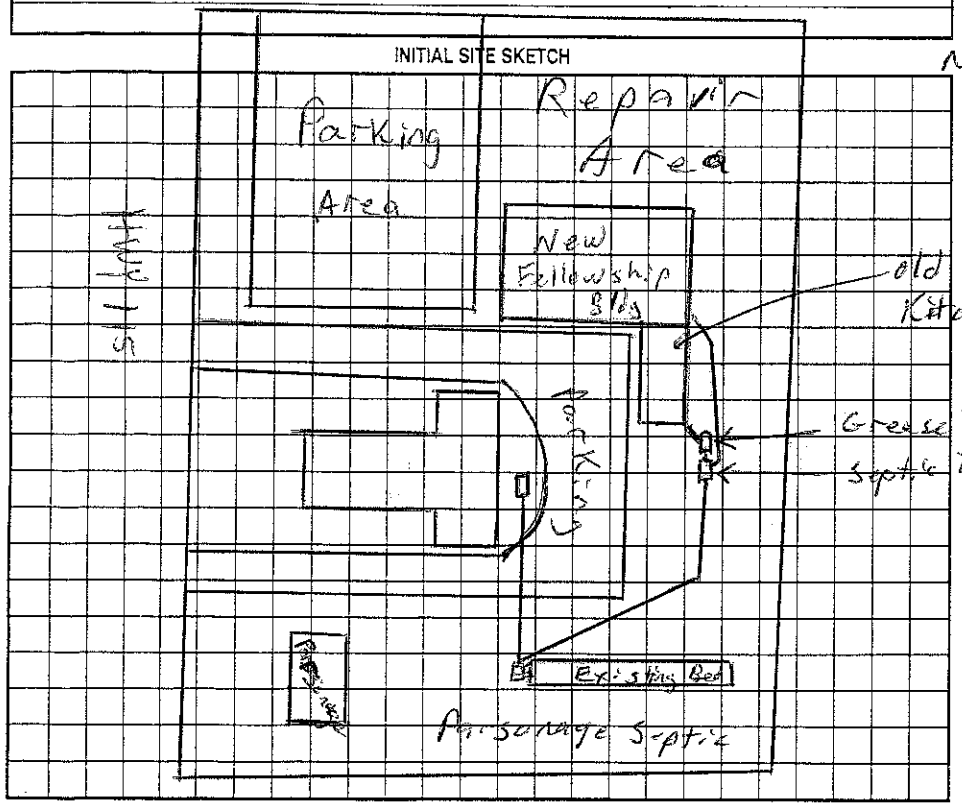

AS BUILT SKETCH

Permit can be suspended or revoked if any false information is supplied toward securing the permit/any unauthorized changes are made to the site/any unauthorized changes are made in the installation of the system. Improvement Permit with plat valid without expiration. Improvement Permit with site plan valid for sixty months. Authorization to Construct is valid for a period equal to that of Improvement Permit – not to exceed sixty months.

Signed: Brenda Lambert date 5/03/05 Installed by:

Improvement Permit by: RS date 4/13/05 Operation Permit by: date 9/1/06

Authorization to Construct by: RS date 4/13/05 Existing System Inspection by: date

HEALTH DEPT. COPY: WHITE OWNER COPY (FINAL): YELLOW OWNER COPY (INITIAL): PINK