IREDELL COUNTY HEALTH DEPARTMENT

STATESVILLE 704-878-5305 MOORESVILLE 704-664-5281

IMPROVEMENT PERMIT / AUTHORIZATION TO CONSTRUCT / OPERATION PERMIT / EXISTING SYSTEM INSPECTION

PERMIT# Repair PIN# 4741-24-4092 DATE 06/23/06

OWNER OR APPLICANT STEVEN GARRIS PHONE: CELL 704-677-2425 Home 704-528-0075

ADDRESS 453 S. MAIN ST. TROUTMAN, NC

LOCATION HWY 21 SOUTH, ON LEFT AT BOX #453;

SUBDIVISION N/A BLOCK / SECTION — LOT — LOT AREA ~1.2 ACRES SITE CLASS. P.S DESIGN FLOW ~~360~~ REPAIR 180 GPD GPD L.T.A.R. 0.30 GPD/FT²

EXIST.

Septic Tank: ____ Gallons: STB ____ Date ____

Pump Tank: ____ Gallons: PT ____ Date ____

Pump Make: ____ Model ____ Serial No. ____

Nitrification Field: No Fields 1 Square Feet 591' Linear Feet 197'

No Lines 2 Trench Width 36" Trench Bottom Depth 40" Gravel Depth 18"

☐ New System ☒ Repair ☐ Expansion System Type: I II III IV V VI

System Description: CONVENTIONAL, GRAVITY

Repair System Description: ~~CONVENTIONAL, GRAVITY~~

Maintenance Agreement Required: ☐ Yes ☒ No

☒ Gravity ☐ Pressure

☒ House/Mod. Home ☐ Mobile Home ☐ Business ☐ Other


No. Bedrooms 3 No. Persons ____ No. Employees ____

☐ Slab ☒ Crawl Space ☐ Basement w/plumbing ☐ Basement wo/plumbing


Water Supply: EXIST. WELL ☒ Individual ☐ Public ☐ Community

Comments/Conditions: (1) CALL HEALTH DEPT. FOR MEETING ON SITE BEFORE INSTALLING. (2) INSTALL TRENCH BOTTOMS STARTING AT 46" DEPTH. (3) USE 18" OF GRAVEL IN TRENCH. (4) DISCONNECT EXIST. DRAIN LINES AND RUN SOLID PVC PIPE TO TOP NEW TRENCH. (5) INSTALL SANITARY TEE AND FILTER IN EXISTING SEPTIC TANK. *ADDITIONAL OR FUTURE REPAIR TO BE PUMPED TO BACK OF PROPERTY IF NEEDED.*

INITIAL SITE SKETCH

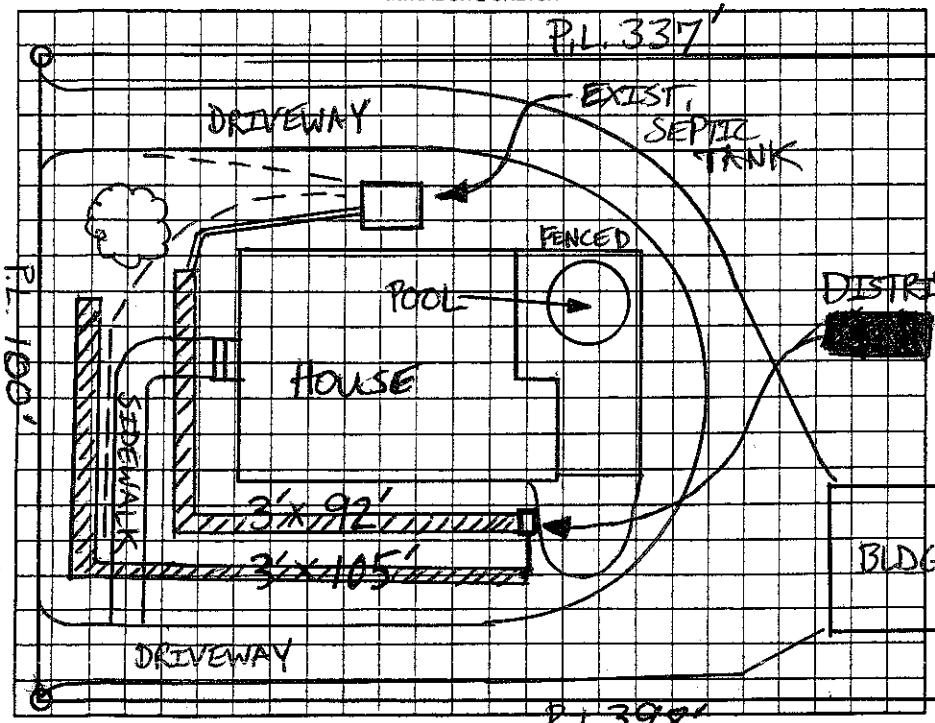

AS BUILT SKETCH

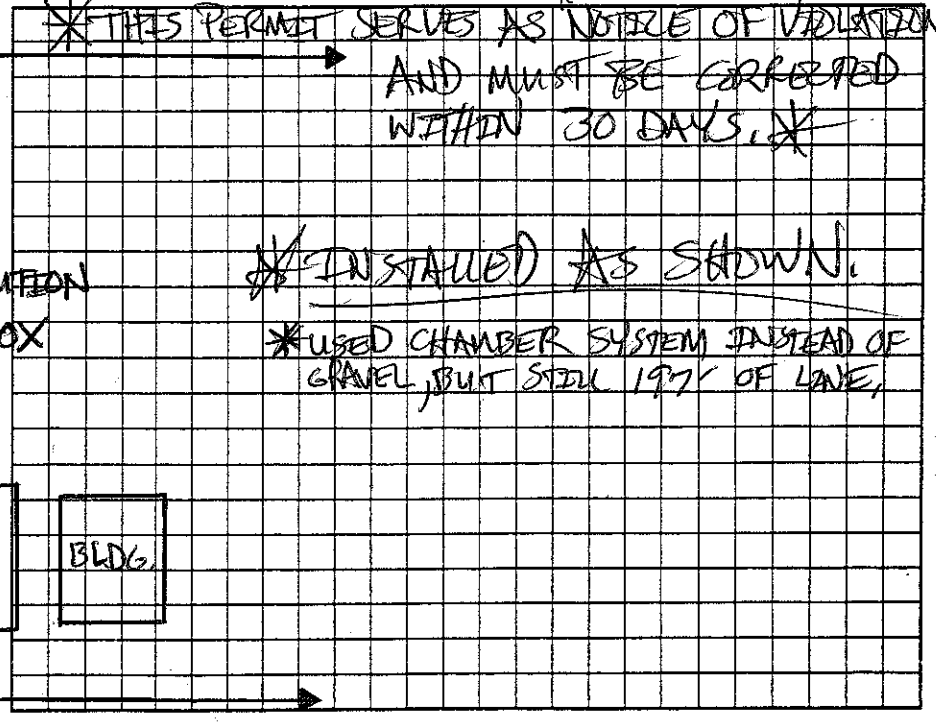

Permit can be suspended or revoked if any false information is supplied toward securing the permit/any unauthorized changes are made to the site/any unauthorized changes are made in the installation of the system. Improvement Permit with plat valid without expiration ☐ Improvement Permit with site plan valid for sixty months ☒ Authorization to Construct is valid for a period equal to that of Improvement Permit – not to exceed sixty months.

Signed: Steven D. Garris date 7-10-06 Installed by: C+J BACKHOE

Improvement Permit by: Patrick Mitchell date 06/23/06 Operation Permit by: Patrick Mitchell date 07/14/06

Authorization to Construct by: Patrick Mitchell date 06/23/06 Existing System Inspection by: ____ date ____

HEALTH DEPT. COPY: WHITE OWNER COPY (FINAL): YELLOW OWNER COPY (INITIAL): PINK