IREDELL COUNTY HEALTH DEPARTMENT

Statesville Office (704) 878-5305 Mooresville Office (704) 660-3625 PERMIT # 221658

IMPROVEMENT PERMIT / AUTHORIZATION TO CONSTRUCT / OPERATION PERMIT / EXISTING SYSTEM

PIN # 4741254589

APPLICANT: Jeff Kelly APPLICANT ADDRESS: 167 Perthwood Dr Troutman NC

SITE ADDRESS: 424 Perry Rd Troutman NC PHONE: 704-528-4901 ALT. PHONE: 704-657-9693

SITE DIRECTIONS: 215 T/L Eastway Dr T/L Perry Rd Lot on right


SUBDIVISION: N/A SECTION: N/A LOT # N/A LOT AREA: 0.8ac DESIGN FLOW: 360 L.T.A.R.: 0.3

Septic Tank	1000 (gal)	STB	1012	Date	11/12/16	[X] New System [ ] Repair [ ] Expansion	System Type: I II [III] IV V VI	[X] Residence	No. Bedrooms 3
Pump Tank	(gal)	PT		Date		System Description:	25% Reduction	[ ] Business	No. Persons 6
Pump Make		Model		Serial #		Repair System Description:	50% Reduction	[ ] Other	No. Employees
# Nitrification Fields	1	# Lines	3	Linear Ft:	300	Maintenance Agreement Required:	[ ] YES [X] NO	[ ] Slab	[X] Crawl Space
Trench Width	36"	Max. Trench Bottom Depth	36"	Gravel Depth	N/A		[X] GRAVITY [ ] PRESSURE	[ ] Basement w/plumbing	[ ] Basement w/o plumbing

Water Supply: [ ] Private [X] Public [ ] Community

Comments / Conditions: Install 25% reduction on contour with serial distribution. * Maintain 36" TD on high side * Pump/crush & fill existing tank.


INITIAL SITE SKETCH

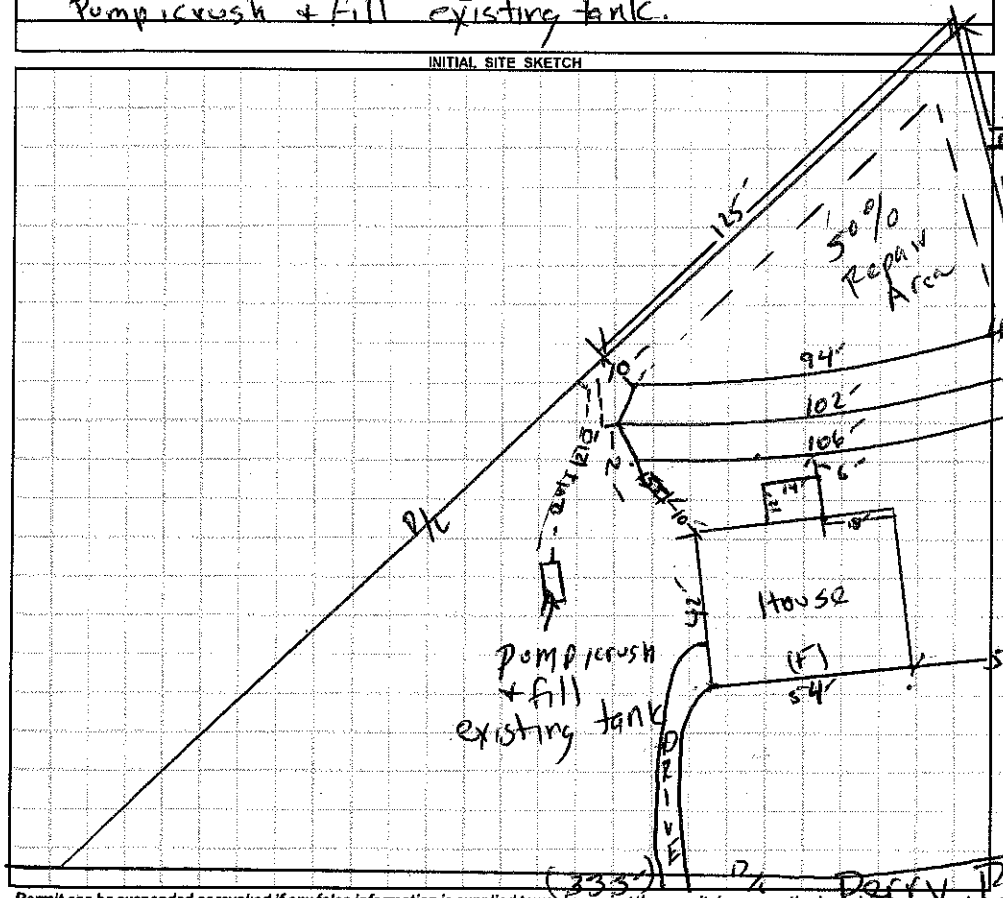

AS BUILT SKETCH

1" = 50'

Installed Quick as drawn

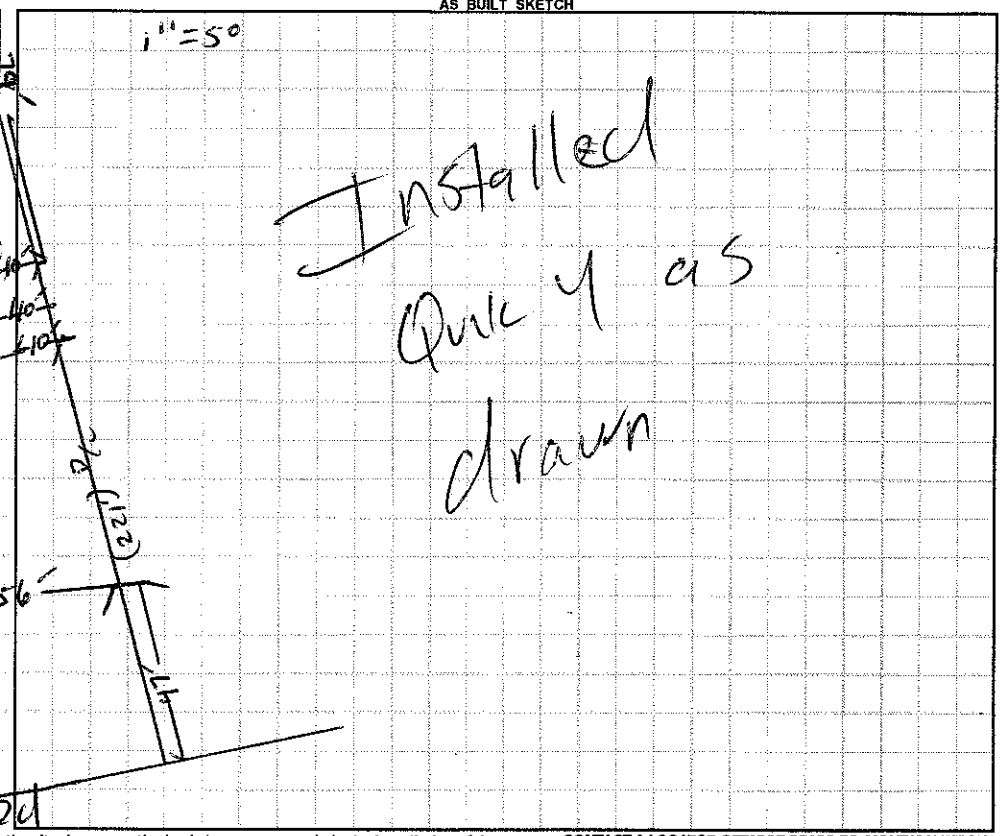

Permit can be suspended or revoked if any false information is supplied toward securing the permit / any unauthorized changes are made to the site / any unauthorized changes are made in the installation of the system. **CONTACT A LOCATOR SERVICE PRIOR TO ANY EXCAVATION**

[ ] **IMPROVEMENT PERMIT** *with plat* valid without expiration [X] **IMPROVEMENT PERMIT** *with site plan* valid for 60 mos. [X] **AUTHORIZATION TO CONSTRUCT** valid for period equal to IMPROVEMENT PERMIT--not to exceed 60 mo.

Owner / Applicant Signature: Jeff Kelly Date: 10-18-16 Installed by: Steve Jordon

IMPROVEMENT PERMIT by: Date: 10/17/16 OPERATION PERMIT by: Date: 03/13/17

AUTHORIZATION TO CONSTRUCT by: Date: 10/17/16 Existing System Inspected by: Date:

Health Dept. Copy - WHITE Applicant (Final Approval) - YELLOW Applicant (Conditional Approval) - PINK