IREDELL COUNTY HEALTH DEPARTMENT

Statesville Office (704) 878-5305 Mooresville Office (704) 660-3625 PERMIT # 179108

IMPROVEMENT PERMIT / AUTHORIZATION TO CONSTRUCT / OPERATION PERMIT / EXISTING SYSTEM

PIN # 4741254970

APPLICANT: Cindy Harris APPLICANT ADDRESS: 122 Victory Ln

SITE ADDRESS: 435 Perry Rd. PHONE: 704-902-6061 ALT. PHONE: N/A

SITE DIRECTIONS: Hwy 21S TL Perry Rd. Property on Left


SUBDIVISION: N/A SECTION: N/A LOT # N/A LOT AREA: 0.5 acres DESIGN FLOW: 360gpd L.T.A.R.: Existing

Septic Tank	1000 (gal)	STB	1160	Date	4-22-13	☐ New System	☑ Repair	☐ Expansion	System Type: I (II) III IV V VI	☑ Residence	No. Bedrooms 3
Pump Tank	(gal)	PT		Date		System Description:				☐ Business	No. Persons
Pump Make	Model			Serial #		Repair System Description:		TANK		☐ Other	No. Employees
# Nitrification Fields	Ex # Lines	Ex		Linear Ft:	Ex	Maintenance Agreement Required:	☐ YES	☑ NO		☐ Slab	☐ Crawl Space
Trench Width	Ex Max. Trench Bottom Depth	Ex		Gravel Depth	Ex		☑ GRAVITY	☐ PRESSURE		☐ Basement w/plumbing	☑ Basement w/o plumbing

Water Supply: ☐ Private ☐ Public ☐ Community

Comments / Conditions: Pump & crush existing septic tank. Install 1000 gallon septic tank at location shown below & connect to existing drainfield.

INITIAL SITE SKETCH

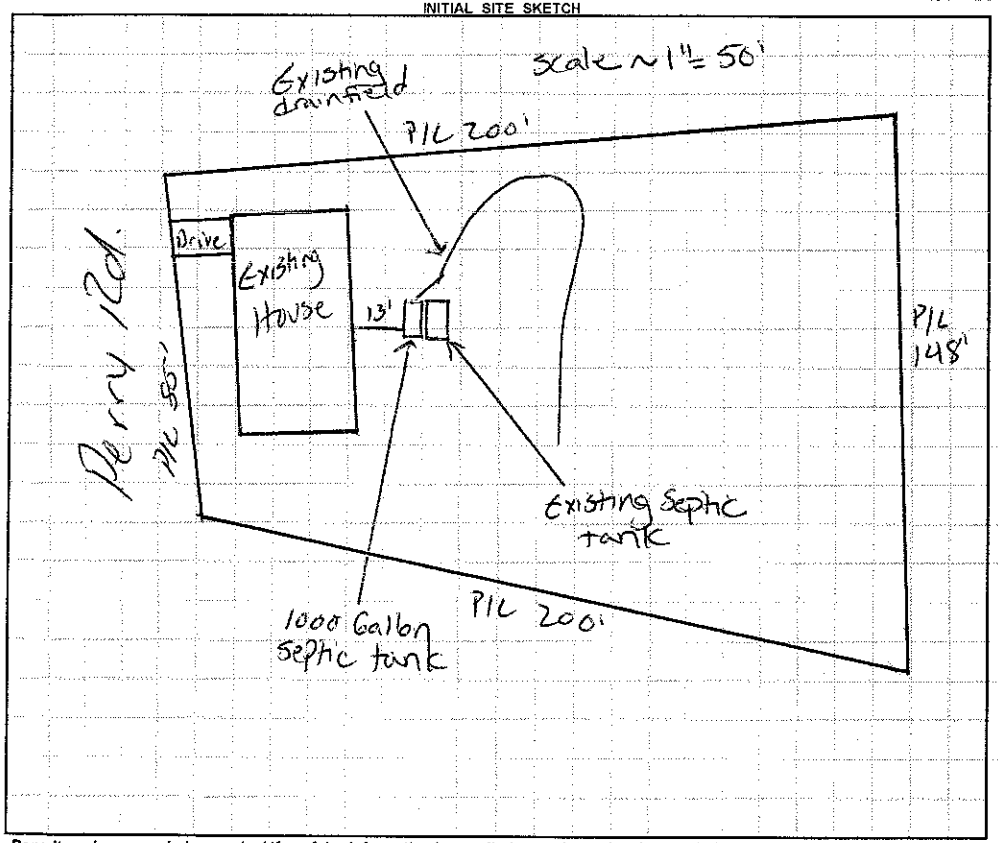

AS BUILT SKETCH

Permit can be suspended or revoked if any false information is supplied toward securing the permit / any unauthorized changes are made to the site / any unauthorized changes are made in the installation of the system. **CONTACT A LOCATOR SERVICE PRIOR TO ANY EXCAVATION**

☐ **IMPROVEMENT PERMIT** *with plat valid without expiration.* ☐ **IMPROVEMENT PERMIT** *with site plan valid for 60 mos.* ☐ **AUTHORIZATION TO CONSTRUCT** *valid for period equal to IMPROVEMENT PERMIT--not to exceed 60 mo.*

Owner / Applicant Signature: Kevin Bowles Date: Installed by: Kevin Bowles

IMPROVEMENT PERMIT by: Justin Rhodes Date: 6-6-13 OPERATION PERMIT by: Date: 7-8-13

AUTHORIZATION TO CONSTRUCT by: Justin Rhodes Date: 6-6-13 Existing System Inspected by: Date:

Health Dept. Copy - WHITE Applicant (Final Approval) - YELLOW Applicant (Conditional Approval) - PINK