IREDELL COUNTY HEALTH DEPARTMENT

STATESVILLE 704-878-5305 CI MOORESVILLE 704-664-5281

CI

IMPROVEMENT PERMIT / AUTHORIZATION TO CONSTRUCT / OPERATION PERMIT / EXISTING SYSTEM INSPECTION

PERMIT# 116/25 PIN# 4741-30-7906 DATE 10/16/03

OWNER OR CONTRACTOR James Goodwin PHONE: Business (704) 400-8315 Home

ADDRESS 4277 Apex Drive Madison N.C. 28650

LOCATION Hwy 21 S of Troutman (R) Bates Road 2nd lot on right past Jacobs Woods Subdivision I

SUBDIVISION Jacobs Woods BLOCK / SECTION II LOT 33 LOT AREA .81 Acre SITE CLASS. 1/5 DESIGN FLOW 360 L.T.A.R. .30 gpd/ft²

Septic Tank: 1000 Gallons; STB 825 Date 8-30-03
Pump Tank: Gallons; PT Date
Pump Make: Model Eljen Serial No.
Nitrification Field: No Fields 1 Square Feet 1440 Linear Feet 300
No Lines 5@60' Trench Width 36" Max Trench Bottom Depth 36" Gravel Depth NA

☒ New System ☐ Repair System Type: I, II, III, IV, V, VI
System Description: Gravity 25% Reduction
Repair System Description: Gravity 25% Reduction
Maintenance Agreement Required: ☐ Yes ☒ No


☒ House/Mod. Home No. Bedrooms 3
☐ Mobile Home No. Bathrooms 3
☐ Business No. Employees
☐ Other
☒ Slab ☐ Crawl Space ☐ Basement w/plumbing ☐ Basement wo/plumbing

Water Supply: ☒ Individual ☐ Public ☐ Community

Comments:/Conditions:

Comments:/Conditions: -poly lok filter Installed
-48 Infiltrator Chambers
Installed 9, 9, 10, 10, 10 ft
top line bottom Ln

INITIAL SITE SKETCH Scale 1" = 50 ft

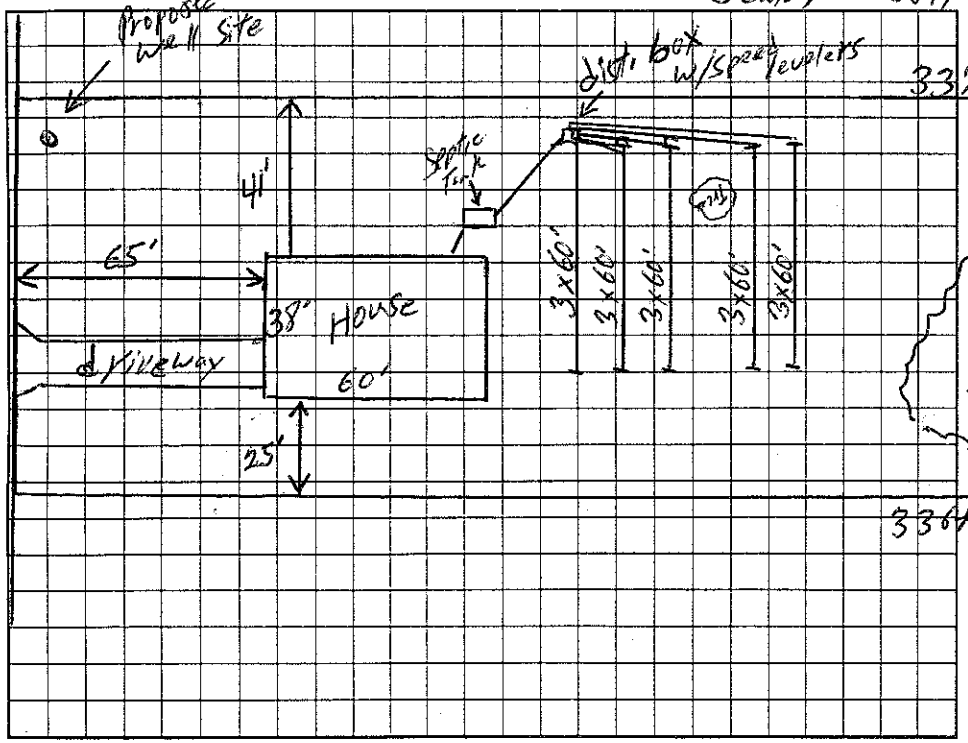

AS BUILT SKETCH

House NOT built @ time of Installation of Septic 10/28/03

Installed As Shown per Initial Site Sketch

Permit can be suspended or revoked if any false information is supplied toward securing the permit/any unauthorized changes are made to the site/any unauthorized changes are made in the installation of the system. Improvement Permit with plat valid without expiration. Improvement Permit with site plan valid for sixty months. Authorization to Construct is valid for a period equal to that of Improvement Permit – not to exceed sixty months.

Signed: Jammy Goodwin date

Improvement Permit by: William O. John date 10/16/03

Authorization to Construct by: William O. John date 10/16/03

Installed by: Rowan Septic

Operation Permit by: William O. John date 10/28/03

Existing System Inspection by: date

HEALTH DEPT. COPY: WHITE OWNER COPY (FINAL): YELLOW OWNER COPY (INITIAL): PINK