IREDELL COUNTY HEALTH DEPARTMENT

STATESVILLE 704-878-5305 MOORESVILLE 704-664-5281

IMPROVEMENT PERMIT / AUTHORIZATION TO CONSTRUCT / OPERATION PERMIT / EXISTING SYSTEM INSPECTION

PERMIT# _____ PIN# 4741-32-5655 DATE 2-16-04

OWNER OR CONTRACTOR DANIEL W UPRIGHT PHONE: Business 704-495-1175 Home 704-871-8283

ADDRESS 450 BARRY OAK RD STATESVILLE, NC 28625

LOCATION 21 SOUTH THRU TROUTMAN, (R) AT BOX # 534 ACROSS FROM EASTWAY DRIVE

SUBDIVISION _____ BLOCK / SECTION _____ LOT _____ LOT AREA .85 AC SITE CLASS. _____ DESIGN FLOW 360 L.T.A.R. _____

Septic Tank: 1000 Gallons; STB 1007 Date 12-5-03
Pump Tank: _____ Gallons; PT _____ Date _____
Pump Make: _____ Model _____ Serial No. _____
Nitrification Field: No Fields ___ Square Feet _____ Linear Feet 250'
No Lines 5X50' Trench Width 36" Max Trench Bottom Depth _____ Gravel Depth 24"

[X] New System [X] Repair System Type: I, (II), III, IV, V, VI
System Description: CONV GRAV
Repair System Description: _____
Maintenance Agreement Required: ☐ Yes [X] No


[X] House/Mod. Home No. Bedrooms 3
☐ Mobile Home No. Bathrooms 2
☐ Business No. Employees ___
☐ Other _____
☐ Slab ☐ Crawl Space ☐ Basement w/plumbing ☐ Basement wo/plumbing

Water Supply: [X] Individual ☐ Public ☐ Community

Comments:/Conditions: (1) CALL PRIOR TO INSTALLATION FOR CONSULTATIVE VISIT + FLAGOUT (2) INSTALL 5 LINES 50' LONG USING 24" OF STONE & NEW TANK, (3) MAINTAIN SEPTIC (4) INSTALL LINES

Comments:/Conditions: SO EFFLUENT WILL BACK UP TO BOX & NOT BLOW OUT OF GROUND; (5) THIS PERMIT SERVES AS NOTICE OF VIOLATION AND MUST BE REPAIRED WITHIN 30 DAYS.

INITIAL SITE SKETCH "NOT TO SCALE"

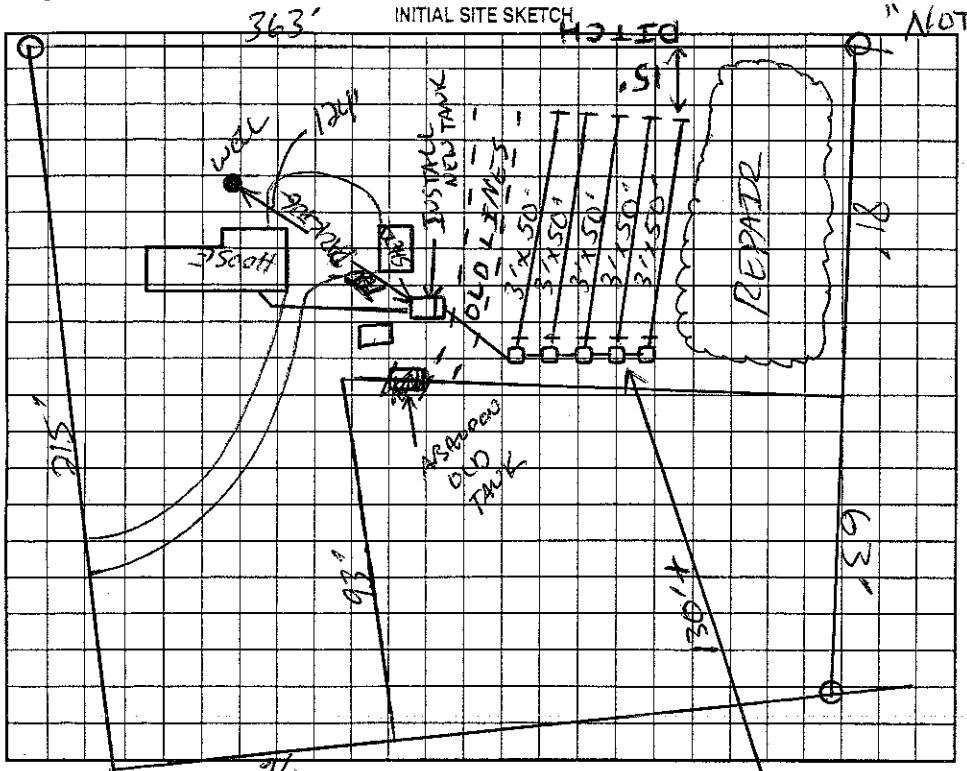

AS BUILT SKETCH

DANIEL UPRIGHT, OWNER, VERIFIED SUPPLY IS 5' OFF P/L & DRAIN LINES IS 16' OFF P/L.

Daniel Upright

3-26-04

SIMTECH FILTER & RISER INSTALLED AS DRAWN

3-26-04 V'D TANK & FIRST 3 LINES
3-29-04 V'D LAST 2 LINES
V'D OK

Permit can be suspended or revoked if any false information is supplied toward securing the permit/any unauthorized changes are made to the site/any unauthorized changes are made in the installation of the system. Improvement Permit with plat valid without expiration. Improvement Permit with site plan valid for sixty months. Authorization to Construct is valid for a period equal to that of Improvement Permit -- not to exceed sixty months.

Signed: Daniel W. Upright date 2-20-04 Installed by: WAYNE CLONTZ 3-29-04

Improvement Permit by: [signature] date 2-16-04 Operation Permit by: [signature] date 3-29-04

Authorization to Construct by: [signature] date 2-16-04 Existing System Inspection by: _____ date _____

HEALTH DEPT. COPY: WHITE OWNER COPY (FINAL): YELLOW OWNER COPY (INITIAL): PINK