IREDELL COUNTY HEALTH DEPARTMENT

Statesville Office (704) 878-5305 — Mooresville Office (704) 660-3625

IMPROVEMENT PERMIT / AUTHORIZATION TO CONSTRUCT / OPERATION PERMIT / EXISTING SYSTEM

Expansion

PERMIT # 22465

PIN # 4741331089

APPLICANT: Paul Williams — APPLICANT ADDRESS: 183 April Rd Troutman, NC 28166

SITE ADDRESS: 504 S Main St Troutman, NC — PHONE: 7049294435 — ALT. PHONE: Greg Moore 7042309097

SITE DIRECTIONS: I-77 exit 42 towards Troutman (Hwy 115) ~2.5 miles house on left before Autumn Leaf

SUBDIVISION: CM Wagoner Prop — SECTION: — LOT # 41243 — LOT AREA: — DESIGN FLOW: 480 gpd — L.T.A.R.: .3

Septic Tank	1000	(gal)	STB	799	Date	1-15-17
Pump Tank		(gal)	PT		Date	
Pump Make			Model		Serial #	
# Nitrification Fields	1		# Lines	4	Linear Ft:	200 ft
Trench Width	36"		Max. Trench Bottom Depth		Gravel Depth	

☐ New System ☐ Repair ☒ Expansion — System Type: I II (III) IV V VI

System Description: Gravity - 25% Reduction

Repair System Description: Paper Black

Maintenance Agreement Required: ☐ YES ☒ NO

☒ GRAVITY ☐ PRESSURE

☒ Residence ☐ Business ☐ Other ☐ Slab ☐ Basement w/plumbing

No. Bedrooms 4 — No. Persons — No. Employees — ☒ Crawl Space


Water Supply: ☐ Private ☒ Public ☐ Community

☐ Basement w/o plumbing

Comments / Conditions: Upgrade to 4 Bedrooms (Existing System is 2 Bedrooms)

* Note: Add to Existing Gravel System. Septic System must be at least 5ft from footers of any Buildings, 5ft from property lines, 50ft from Well & 10ft from water lines

INITIAL SITE SKETCH

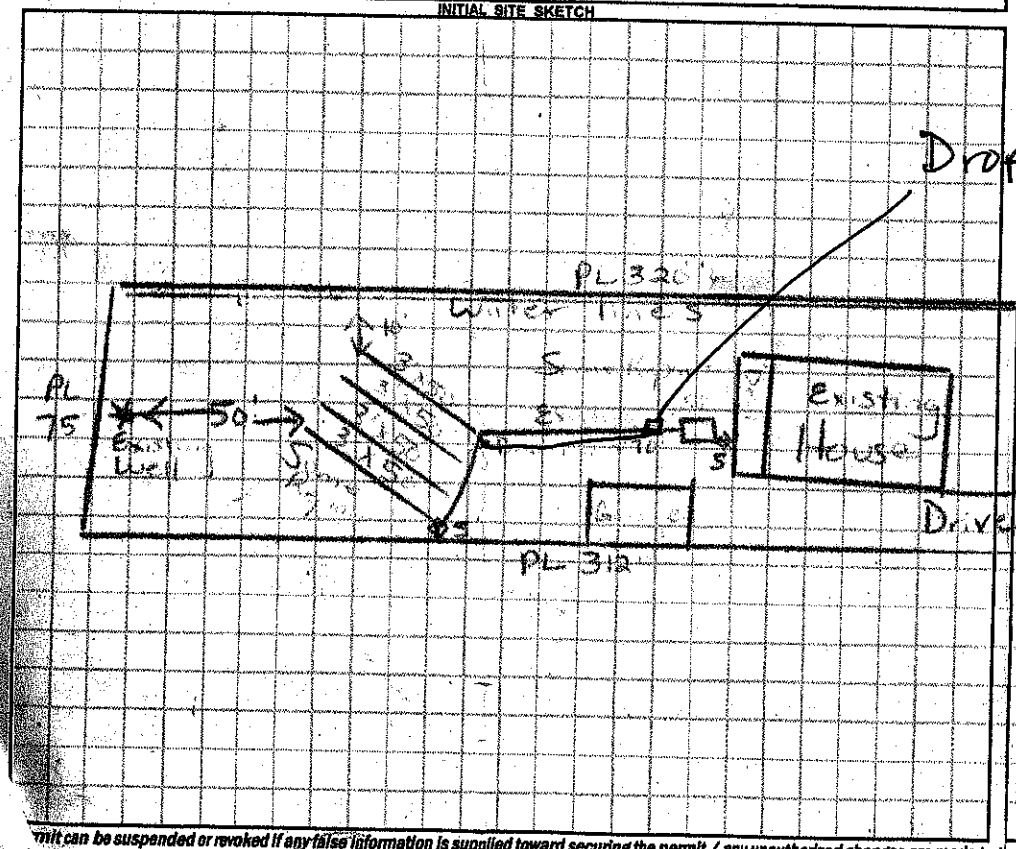

AS BUILT SKETCH

Permit can be suspended or revoked if any false information is supplied toward securing the permit / any unauthorized changes are made to the site / any unauthorized changes are made in the installation of the system. CONTACT A LOCATOR SERVICE PRIOR TO ANY EXCAVATION

☐ IMPROVEMENT PERMIT with plat valid without expiration. ☐ IMPROVEMENT PERMIT with site plan valid for 60 mos. ☒ AUTHORIZATION TO CONSTRUCT valid for period equal to IMPROVEMENT PERMIT--not to exceed 60 mo.

Applicant Signature: — Date: 1/25/17 — Installed by: Richard Abernathy

IMPROVEMENT PERMIT by: Maria Dolson RS — Date: 11/18/16 — OPERATION PERMIT by: Maria Dolson — Date: 3/1/17

AUTHORIZATION TO CONSTRUCT by: Maria Dolson RS — Date: 11/18/16 — Existing System Inspected by: — Date:

Health Dept. Copy - WHITE Applicant (Final Approval) - YELLOW Applicant (Conditional Approval) - PINK