IREDELL COUNTY HEALTH DEPARTMENT

STATESVILLE 704-878-5305 MOORESVILLE 704-664-5281

IMPROVEMENT PERMIT / AUTHORIZATION TO CONSTRUCT / OPERATION PERMIT / EXISTING SYSTEM INSPECTION

PERMIT # 152783 PIN # 4741-33 1240 DATE 8-18-09

OWNER or APPLICANT David Sharp PHONE: Business Home:

OWNER or APPLICANT ADDRESS 214 Brown Street Troutman NC

LOCATION / DIRECTIONS 505 main street troutman ⇨ past grade school on left

SUBDIVISION BLOCK / SECTION LOT # 37 LOT AREA DESIGN FLOW 240 1000 gal L.T.A.R. EXist

Septic Tank Exist Gallons: STB Date

Pump Tank Gallons: P T Date

Pump Make Model Serial #

Nitrification Field No Fields No Lines Bed Linear Feet Exist

Trench Width Exist Max. Trench Bottom Depth Exist Gravel Depth Exist

~~New System~~ Repair Expansion System Type I II III IV V VI

System Description: Gravel Bed

Repair System Description: 25% Gravity

Maintenance Agreement Required YES NO

GRAVITY PRESSURE

Residence No. Bedrooms 2

Business No. Persons

Other No. Employees

Slab Crawl Space

Basement w/plumbing Basement w/o plumbing

Water Supply: Private Public Community


Comments / Conditions

Comments / Conditions

Not found by inspector ND
Failure D

INITIAL SITE SKETCH

AS BUILT SKETCH

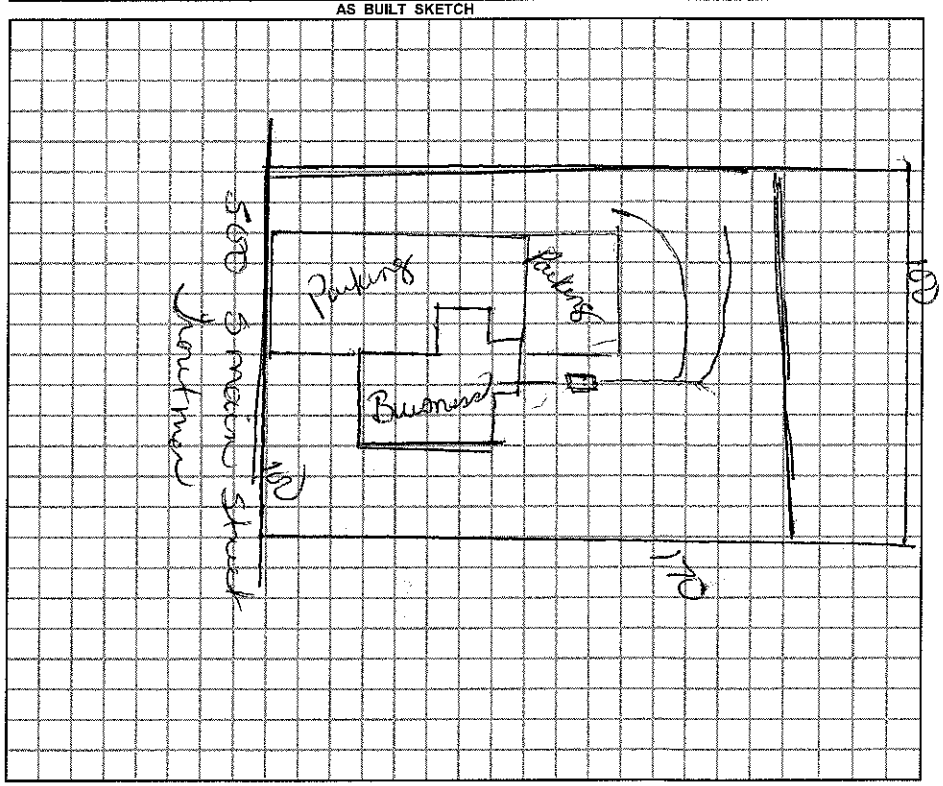

Permit can be suspended or revoked if any false information is supplied toward securing the permit / any unauthorized changes are made to the site / any unauthorized changes are made in the installation of the system.

☐ *IMPROVEMENT PERMIT w / plat valid without expiration.* ☐ *IMPROVEMENT PERMIT w / site plan valid for 60 mos.* ☑ *AUTHORIZATION TO CONSTRUCT valid for period equal to IMPROVEMENT PERMIT-not to exceed 60 mo.*

Owner / Applicant Signature: Date

Improvement Permit by: Date

Authorzation to Construct by: Date

YOU SHOULD CONTACT A LOCATOR SERVICE PRIOR TO ANY EXCAVATION.

Installed by:

Operation Permit by: Date:

Existing System Inspected by: Date: 8-18-09

WHITE COPY Environmental Health YELLOW COPY (Final) Owner / Applicant PINK COPY (Initial) Owner / Applicant