IREDELL COUNTY HEALTH DEPARTMENT

STATESVILLE 704-878-5305 MOORESVILLE 704-664-5281

IMPROVEMENT PERMIT / CERTIFICATE OF COMPLETION / OPERATION PERMIT / EXISTING SYSTEM INSPECTION

PROPERTY DESCRIPTION NO. Trautman DATE 3-17-97 TAX MAP NO. 4N-1-E-10B Watershed: ☐ Yes ☑ No

OWNER OR CONTRACTOR Roger Mannel PHONE: Business 872-3739 Home

ADDRESS [redacted] 229 Belfast Rd Statesville, N.C.

LOCATION 21 South of Trautman TR Byers Rd 1/4 mi left

SUBDIVISION James Trautman (Jacob Woods) BLOCK / SECTION LOT 9 LOT AREA 1.52 acres SITE CLASS. PS DESIGN FLOW 360 L.T.A.R. [redacted] 1.3

Septic Tank: 1000 Gallons; STB D12 Date 3-11-98

Pump Tank: Gallons; PT Date

Pump Make: Model Serial No.

Nitrification Field: No Fields 1 Square Feet 1200 Linear Feet 400

No Lines 5 Trench Width 36" Max Trench Bottom Depth 36" Gravel Depth 12"

☑ New System ☐ Repair System Type: I, II, III, IV, V, VI

System Description: Conv. Gravity

Repair System Description: Gravity Chambers

Maintenance Agreement Required: ☐ Yes ☑ No

☑ House/Mod. Home ☐ Mobile Home ☐ Business ☐ Other

No. Bedrooms 3 No. Bathrooms 2 No. Employees


☐ Slab ☑ Crawl Space ☐ Basement w/plumbing ☐ Basement wo/plumbing

Water Supply: ☑ Individual ☐ Community ☐ Public


Comments:

Comments:

INITIAL SITE SKETCH

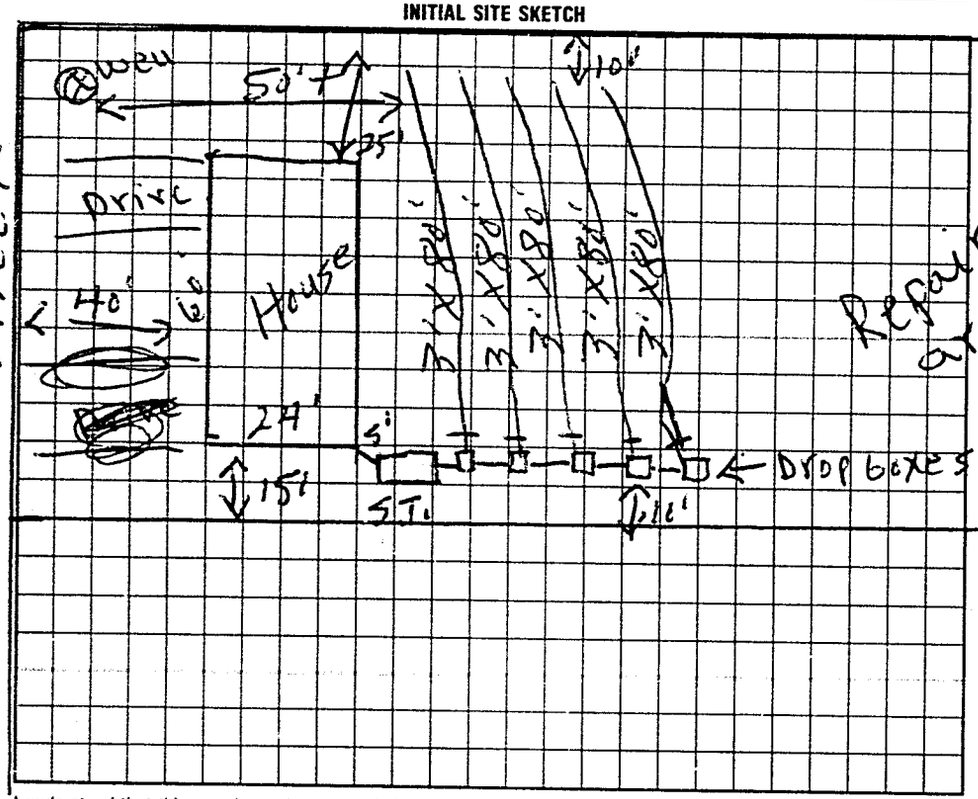

AS BUILT SKETCH

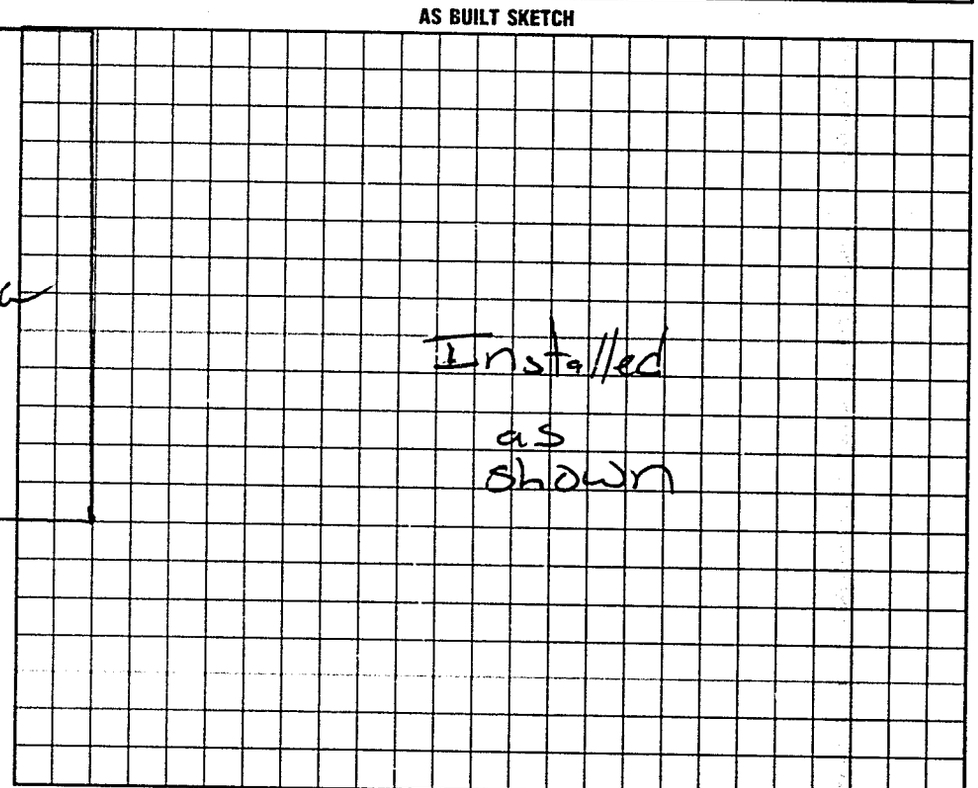

I understand that this permit can be suspended or revoked if any false information is supplied toward securing the permit/any unauthorized changes are made to the site/any unauthorized changes are made in the installation of the system. Improvement Permit valid for 60 months from date of issuance.

Signed: Roger Mannel

Improvement Permit by: P. C. Moore date 3-17-97

Authorization Existing System Inspection by: J. C. Moore date 3-17-97

Installed by: A-1

Certificate of Completion by: date

Operation Permit by: Mark C. Oakley RS date 5-14-98

TO CATHY IN DEPT COPY-WHITE INSPECTION COPY (FINAL) GREEN OWNER COPY (FINAL) YELLOW INSPECTION COPY (INITIAL) PINK OWNER COPY (INITIAL) GOLD

Authorization to count expires 60 months from issue.

7852708